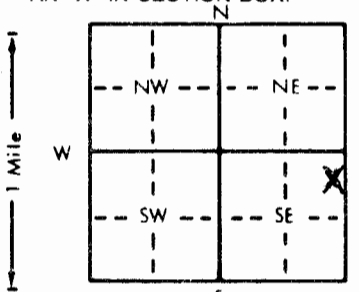


1 LOCATION OF WATER WELL:		Fraction	Section Number	Township Number	Range Number
County: Butler		NE 1/4 NE 1/4 SE 1/4	16	T 28 S	R 4 EW
Distance and direction from nearest town or city street address of well if located within city? From the SE corner of section 16, 2061' N., 75' W.					
2 WATER WELL OWNER: Oliver F. Todd					
RR#, St. Address, Box # : 14617 S. Hunter Rd.					
City, State, ZIP Code : Augusta, Ks., 67010					
Board of Agriculture, Division of Water Resources Application Number:					
3 LOCATE WELL'S LOCATION WITH AN "X" IN SECTION BOX:		4 DEPTH OF COMPLETED WELL 37 ft. ELEVATION:			
		Depth(s) Groundwater Encountered 1. 30 ft. 2. ft. 3. ft.			
		WELL'S STATIC WATER LEVEL 15 ft. below land surface measured on mo/day/yr 4/14/95			
		Pump test data: Well water was ft. after hours pumping gpm			
		Est. Yield 6 gpm: Well water was ft. after hours pumping gpm			
		Bore Hole Diameter 10 in. to 37 ft. and in. to ft.			
		WELL WATER TO BE USED AS:			
		1 Domestic 3 Feedlot 6 Oil field water supply 9 Dewatering 12 Other (Specify below)			
		2 Irrigation 4 Industrial 7 Lawn and garden only 10 Monitoring well			
		Was a chemical/bacteriological sample submitted to Department? Yes No X If yes, mo/day/yr sample was submitted			
		Water Well Disinfected? Yes X No			
5 TYPE OF BLANK CASING USED:					
1 Steel 3 RMP (SR) 5 Wrought iron 8 Concrete tile CASING JOINTS: Glued Clamped					
2 PVC 4 ABS 6 Asbestos-Cement 9 Other (specify below) Welded					
7 Fiberglass Threaded					
Blank casing diameter 6 in. to 17 ft. Dia in. to ft.					
Casing height above land surface 18 in. weight 160 lbs./ft. Wall thickness or gauge No.					
TYPE OF SCREEN OR PERFORATION MATERIAL:					
1 Steel 3 Stainless steel 5 Fiberglass 8 RMP (SR) 11 Other (specify)					
2 Brass 4 Galvanized steel 6 Concrete tile 9 ABS 12 None used (open hole)					
SCREEN OR PERFORATION OPENINGS ARE:					
1 Continuous slot 3 Mill slot 5 Gauzed wrapped 8 Saw cut 11 None (open hole)					
2 Louvered shutter 4 Key punched 6 Wire wrapped 9 Drilled holes					
7 Torch cut 10 Other (specify)					
SCREEN-PERFORATED INTERVALS: From 37 ft. to 17 ft. From ft. to ft.					
GRAVEL PACK INTERVALS: From 37 ft. to 16 ft. From ft. to ft.					
6 GROUT MATERIAL: 1 Neat cement 2 Cement grout 3 Bentonite 4 Other					
Grout Intervals: From 16 ft. to 15 (2) ft. From 15 ft. to 0 (3) ft. From ft. to ft.					
What is the nearest source of possible contamination:					
1 Septic tank 4 Lateral lines 7 Pit privy 11 Fuel storage 14 Abandoned water well					
2 Sewer lines 5 Cess pool 8 Sewage lagoon 12 Fertilizer storage 15 Oil well/Gas well					
3 Watertight sewer lines 6 Seepage pit 9 Feedyard 13 Insecticide storage 16 Other (specify below)					
Direction from well? South How many feet? 200					
FROM TO LITHOLOGIC LOG FROM TO PLUGGING INTERVALS					
0.0 30.0 Reddish brown clay					
30.0 37.0 Rock tallus, (hill gravel), limestone, and chert fragments up to 2"					
37.0 40.0 Brownish, reddish brown clay					
*The well caved in the gravel section during casing. Well cased to 37'.					
7 CONTRACTOR'S OR LANDOWNER'S CERTIFICATION: This water well was (1) constructed, (2) reconstructed, or (3) plugged under my jurisdiction and was completed on (mo/day/year) 4/14/95 and this record is true to the best of my knowledge and belief. Kansas Water Well Contractor's License No. 279 This Water Well Record was completed on (mo/day/yr) 4/18/95 under the business name of Fudge Drilling by (signature) <i>Mehrin R. Fudge</i>					