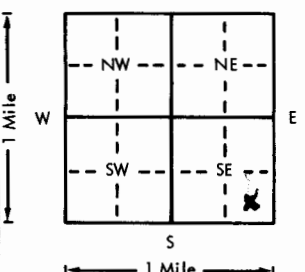


USE TYPEWRITER OR BALL
POINT PEN-PRESS FIRMLY,
PRINT CLEARLY.

WATER WELL RECORD
KSA 82a-1201-1215

Kansas Department of Health and
Environment-Division of Environment
(Water well Contractors)
Topeka, Kansas 66620

1. Location of well:	County Butler	Fraction SE 1/4 SE 1/4 SE 1/4	Section number 6	Township number T 28 S	Range number R 5 E
2. Distance and direction from nearest town or city: Street address of well location if in city:	3 E 3 S Augusta		3. Owner of well: R.R. or street: City, state, zip code: Bill Stovall 1250 Reece Rd Holdard		
4. Locate with "X" in section below: N W E S 1 Mile 1 Mile			Sketch map: 		
5. Type and color of material			From	To	6. Bore hole dia. _____ in. Completion date _____ Well depth 100 ft. 4-4-1977
					7. ☒ Cable tool _____ Rotary _____ Driven _____ Dug _____ _____ Hollow rod _____ Jetted _____ Bored _____ Reverse rotary
					8. Use: _____ Domestic _____ Public supply _____ Industry _____ _____ Irrigation _____ Air conditioning _____ Stock _____ _____ Lawn _____ Oil field water _____ Other _____
					9. Casing: Material _____ Height: Above or below _____ Threaded _____ Welded _____ Surface _____ in. _____ RMP _____ PVC _____ Weight _____ lbs./ft. _____ Dia. _____ in. to _____ ft. depth Wall Thickness: inches or _____ Dia. _____ in. to _____ ft. depth gage No. _____
					10. Screen: Manufacturer's name _____ Type _____ Dia. _____ Slot/gauze _____ Length _____ Set between _____ ft. and _____ ft. _____ _____ ft. and _____ ft. _____ Gravel pack? _____ Size range of material _____
					11. Static water level: _____ mo./day/yr. _____ _____ ft. below land surface Date _____
					12. Pumping level below land surfaces: _____ ft. after _____ hrs. pumping _____ g.p.m. _____ _____ ft. after _____ hrs. pumping _____ g.p.m. _____ Estimated maximum yield 3 g.p.m. _____
					13. Water sample submitted: _____ mo./day/yr. _____ Yes ☒ No _____ Date _____
					14. Well head completion: _____ Pitless adapter _____ Inches above grade
					15. Well grouted? _____ With: _____ Neat cement _____ Bentonite _____ Concrete _____ Depth: From _____ ft. to _____ ft. _____
					16. Nearest source of possible contamination: ft. _____ Direction _____ Type _____ Well disinfected upon completion? _____ Yes _____ No
					17. Pump: _____ Not installed Manufacturer's name _____ Model number _____ HP _____ Volts _____ Length of drop pipe _____ ft. capacity _____ g.p.m. _____ Type: _____ Submersible _____ Turbine _____ _____ Jet _____ Reciprocating _____ _____ Centrifugal _____ Other _____
					20. Water well contractor's certification: This well was drilled under my jurisdiction and this report is true to the best of my knowledge and belief. Wike well Drilling 122 Business name _____ License No. _____ Address Rt 3 Augusta Signed Murray Wike Date 4-4-1977 Authorized representative
18. Elevation:	19. Remarks:				
Topography: _____ Hill _____ Slope ☒ Upland _____ Valley					

Forward the white, blue and pink copies to the Department of Health and Environment

Form WWC-5