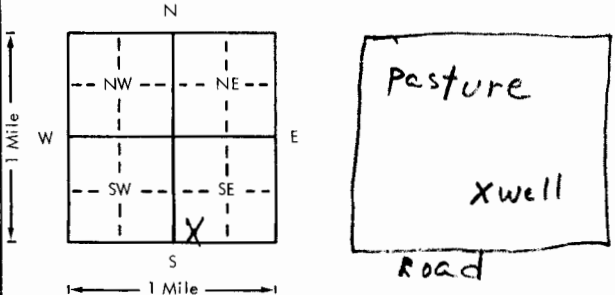


USE TYPEWRITER OR BALL
POINT PEN-PRESS FIRMLY,
PRINT CLEARLY.

WATER WELL RECORD
KSA 82a-1201-1215

Kansas Department of Health and
Environment-Division of Environment
(Water well Contractors)
Topeka, Kansas 66620

1. Location of well:	County Butler	Fraction SE 1/4 SW 1/4 SE 1/4	Section number 29	Township number T 28 S	Range number R 5 E
2. Distance and direction from nearest town or city: 7 mi S 4 E of Augusta		3. Owner of well: RONNIE RIERSON R.R. or street: #9 Tippyary Ct. City, state, zip code: Augusta KS,			
4. Locate with "X" in section below: 		6. Bore hole dia. 8.5 in. Completion date 4-15-78 Well depth 138 ft.			
5. Type and color of material		7. ☒ Cable tool ☐ Rotary ☐ Driven ☐ Dug ☐ Hollow rod ☐ Jetted ☐ Bored ☐ Reverse rotary			
8. Use: ☒ Domestic ☐ Public supply ☐ Industry ☐ Irrigation ☐ Air conditioning ☐ Stock ☐ Lawn ☐ Oil field water ☐ Other		9. Casing: Material PVC Height: Above or below Threaded ☐ Welded ☐ Surface 24 in. RMP ☒ PVC ☐ Weight 138 lbs./ft. Dia. 5 in. to 138 ft. depth Wall Thickness: inches or Dia. 138 in. to 138 ft. depth gage No. 120			
10. Screen: Manufacturer's name SanFlow Plastic Pipe Inc Type RMP Dia. 5 in Flow gauge V66 Length 20 ft Set between 118 ft. and 138 ft. Gravel pack? No Size range of material		11. Static water level: 45 ft. below land surface Date 4-15-78			
12. Pumping level below land surfaces: NA ft. after NA hrs. pumping NA g.p.m. ft. after NA hrs. pumping NA g.p.m. Estimated maximum yield NA g.p.m.		13. Water sample submitted: Yes ☒ No ☐ Date			
14. Well head completion: 24 inches above grade Pitless adapter 24 inches above grade		15. Well grouted? yes With: ☐ Neat cement ☐ Bentonite ☒ Concrete Depth: From 4 ft. to 40 ft.			
16. Nearest source of possible contamination: ft. 300 Direction E Type Dwelling Well disinfected upon completion? ☒ Yes ☐ No		17. Pump: ☒ Not installed Manufacturer's name Model number HP Volts Length of drop pipe ft. capacity g.p.m. Type: ☐ Submersible ☐ Turbine ☐ Jet ☐ Reciprocating ☐ Centrifugal ☐ Other			
18. Elevation: Topography: ☐ Hill ☒ Slope ☐ Upland ☐ Valley		19. Remarks: Concrete slab to be installed By Customer.			
20. Water well contractor's certification: This well was drilled under my jurisdiction and this report is true to the best of my knowledge and belief. Braddy Water Wells 363 Business name License No. Address Box 217A Douglass KS Signed Richard Braddy Date 4-30-78 Authorized representative					

Forward the white, blue and pink copies to the Department of Health and Environment

Form WWC-5