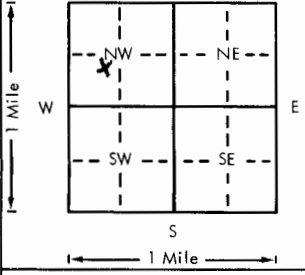
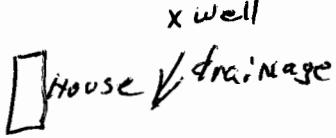


USE TYPEWRITER OR BALL
POINT PEN-PRESS FIRMLY,
PRINT CLEARLY.

WATER WELL RECORD
KSA 82a-1201-1215

Kansas Department of Health and
Environment-Division of Environment
(Water well Contractors)
Topeka, Kansas 66620

1. Location of well:		County Butler	Fraction NE 1/4 SW 1/4 NW 1/4	Section number 32	Township number T 28	Range number S 5 R 5 E 4
2. Distance and direction from nearest town or city: 2 W 3 3/4 N of Smileyville		3. Owner of well: David RENISBERG		R.R. or street: R1 City, state, zip code: Valley Center KS 67147		
4. Locate with "X" in section below:		Sketch map:		6. Bore hole dia. 8.5 in. Completion date 12-16-78 Well depth 65 ft.		
				7. ☒ Cable tool ☐ Rotary ☐ Driven ☐ Dug ☐ Hollow rod ☐ Jetted ☐ Bored ☐ Reverse rotary		
5. Type and color of material		From		To		8. Use: ☒ Domestic ☐ Public supply ☐ Industry ☐ Irrigation ☐ Air conditioning ☐ Stock ☐ Lawn ☐ Oil field water ☐ Other
Top Soil		0		1		9. Casing: Material Plts Height: Above or below Threaded ☐ Welded g1/4 Surface 12 in. RMP ☒ PVC ☐ Weight ☐ lbs./ft. Dia. 5 in. to 65 ft. depth Wall Thickness: inches or Dia. ☐ in. to ☐ ft. depth gage No. 200
Clay Brown		1		4		10. Screen: Manufacturer's name SENFLOWER ME3 Type RMP Dia. 5" Slot/gauze 1/16 Length 10' Set between 35 ft. and 65 ft. ft. and ft. Gravel pack? NO Size range of material
Clay with limestone yellow		4		22		11. Static water level: ☐ mo./day/yr. 37 ft. below land surface Date 12-16-78
Limestone yellow		22		45		12. Pumping level below land surfaces: NA ft. after hrs. pumping g.p.m. ft. after hrs. pumping g.p.m. Estimated maximum yield g.p.m.
Limestone light gray (water at 45')		45		65		13. Water sample submitted: ☐ mo./day/yr. Yes ☒ No Date
						14. Well head completion: ☒ Pitless adapter 12 Inches above grade
						15. Well grouted? yes With: ☐ Neat cement ☐ Bentonite ☒ Concrete Depth: From 25 ft. to 4 ft.
						16. Nearest source of possible contamination: NA ft. Direction Type Well disinfected upon completion? ☒ Yes ☐ No
						17. Pump: ☒ Not installed Manufacturer's name Model number HP Volts Length of drop pipe ft. capacity g.p.m. Type: ☐ Submersible ☐ Turbine ☐ Jet ☐ Reciprocating ☐ Centrifugal ☐ Other
						20. Water well contractor's certification: This well was drilled under my jurisdiction and this report is true to the best of my knowledge and belief. Brady Water Wells 363 Business name License No. Address R2 Douglass KS Signed Richard Brady Date 12-16-78 Authorized representative
18. Elevation:		19. Remarks: owner will install concrete slab				
Topography: ☐ Hill ☐ Slope ☐ Upland ☐ Valley						

Forward the white, blue and pink copies to the Department of Health and Environment

Form WWC-5