

County: Butler Fraction: NW SW SE NE Sec. 33 T 28 S R 6 E

**CORRECTION(S) TO WATER WELL COMPLETION RECORD Form WWC-5 (to rectify lacking or incorrect information)**

Owner: 22<sup>nd</sup> CES CEVQ USAF

If location corrected, was listed as:

Location changed to:

Section-Township-Range: 33-285-6E

33-285-6E

Fraction (¼ calls): SW SW SE NE

NW SW SE NE

Other changes: Initial statements: Longitude: -97.7741

From: . . . . SE 70<sup>th</sup> St. . . . .

Changed to: Longitude: -96.7741

From . . . . SE 170<sup>th</sup> St. . . . .

Comments: \_\_\_\_\_

Verification method: Legal & written descriptions, corrected Lat./Long. & KGS' "LEWEB" conversion tool, and KGS' online mapping tool & aerial photos.

Initials: DRL Date: 9/27/2018

Submitted by:  Kansas Geological Survey, Data Resources Library, 1930 Constant Avenue, Lawrence, KS 66047-3724  
 Kansas Dept. of Health & Environment, Bureau of Water, 1000 SW Jackson, Suite 420, Topeka, KS 66612-1367

**WATER WELL PLUGGING RECORD Form WWC-5P**

KSA 82a-1212 ID NO.

MS05-MW3


|   |  |                             |                                  |   |
|---|--|-----------------------------|----------------------------------|---|
| <b>1 LOCATION OF WATER WELL:</b><br>County: <b>Butler</b> | Fraction<br><b>SW ¼ SW ¼ SE ¼ NE ¼</b> | Section Number<br><b>33</b> | Township Number<br><b>T 28 S</b> | Range Number<br><b>6</b> <input checked="" type="checkbox"/> E <input type="checkbox"/> W |
|---|--|-----------------------------|----------------------------------|---|

Street/Rural Address of Well Location; if unknown, distance & direction from nearest town or intersection: If at owner's address, check here  From **SE Cole Creek Road & SE 70th St. travel 2350 ft. S to unnamed road then 830 ft. W from this point**

**Global Positioning Systems (GPS) information:**  
 Latitude: **37.5721** (in decimal degrees)  
 Longitude: **-97.7741** (in decimal degrees)  
 Elevation: **1425.42(TOC)**  
 Horizontal Datum:  WGS84,  NAD83,  NAD27  
 Collection Method:

**2 WATER WELL OWNER:** **ZZ<sup>nd</sup> CES CEUQ USHF**  
 RR#, St. Address, Box #: **5300 Hutchinson St, Ste 109**  
 City, State ZIP Code: **Wichita, KS 67211** **MARFB**

GPS unit (Make/Model: **NA**)  
 Digital Map/Photo,  Topographic Map,  Land Survey  
 Est. Accuracy:  < 3 m,  3-5 m,  5-15 m,  > 15 m

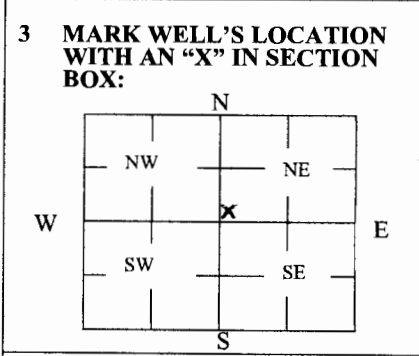

**4 DEPTH OF WELL** 23.0 ft.  
 WELL'S STATIC WATER LEVEL 8.40 ft

WELL WAS USED AS:

|                                     |   |  |
|-------------------------------------|---|--|
| <input type="checkbox"/> Domestic   | <input type="checkbox"/> Public Water Supply      | <input type="checkbox"/> Dewatering            |
| <input type="checkbox"/> Irrigation | <input type="checkbox"/> Oil Field Water Supply   | <input checked="" type="checkbox"/> Monitoring |
| <input type="checkbox"/> Feedlot    | <input type="checkbox"/> Domestic (Lawn & Garden) | <input type="checkbox"/> Injection Well        |
| <input type="checkbox"/> Industrial | <input type="checkbox"/> Air Conditioning         | <input type="checkbox"/> Other _____           |

Was a chemical/bacteriological sample submitted to Department? Yes  No

**5 TYPE OF BLANK CASING USED:**

|   |                                   |  |  |  |
|---|-----------------------------------|--|--|--|
| <input checked="" type="checkbox"/> Steel | <input type="checkbox"/> RMP (SR) | <input type="checkbox"/> Wrought         | <input type="checkbox"/> Fiberglass    | <input type="checkbox"/> Other (Specify below) _____ |
| <input checked="" type="checkbox"/> PVC   | <input type="checkbox"/> ABS      | <input type="checkbox"/> Asbestos-Cement | <input type="checkbox"/> Concrete Tile |  |

Blank casing diameter 2 in. Was casing pulled? Yes  No  If yes, how much 3 ft.  
 Casing height above or below land surface -36 in.

**6 GROUT PLUG MATERIAL:**  Neat cement  Cement grout  Bentonite  Other \_\_\_\_\_

Grout Plug Intervals: From 0 ft. to 23.0 ft., From \_\_\_\_\_ ft. to \_\_\_\_\_ ft., From \_\_\_\_\_ ft. to \_\_\_\_\_ ft.

What is the nearest source of possible contamination:

|   |   |   |  |
|---|---|---|--|
| <input type="checkbox"/> Septic tank            | <input type="checkbox"/> Seepage pit    | <input type="checkbox"/> Fuel storage         | <input type="checkbox"/> Other (specify below) _____ |
| <input type="checkbox"/> Sewer lines            | <input type="checkbox"/> Pit privy      | <input type="checkbox"/> Fertilizer storage   |  |
| <input type="checkbox"/> Watertight sewer lines | <input type="checkbox"/> Sewage lagoon  | <input type="checkbox"/> Insecticide storage  |  |
| <input type="checkbox"/> Lateral lines          | <input type="checkbox"/> Feedyard       | <input type="checkbox"/> Abandoned water well | Direction from well? _____                           |
| <input type="checkbox"/> Cess pool              | <input type="checkbox"/> Livestock pens | <input type="checkbox"/> Oil well/Gas well    | How many feet? _____                                 |

| FROM | TO   | PLUGGING MATERIALS | FROM | TO | PLUGGING MATERIALS |
|------|------|--------------------|------|----|--------------------|
| 0    | 23.0 | Bentonite grout    |      |    |                    |
|      |      |                    |      |    |                    |
|      |      |                    |      |    |                    |
**7 CONTRACTOR'S OR LANDOWNER'S CERTIFICATION:** This water well was plugged under my jurisdiction and was completed on (mo/day/year) 7/12/2018 and this record is true to the best of my knowledge and belief. Kansas Water Well Contractor's License No. 604. This Water Well Record was completed on (mo/day/year) 8/10/18 under the business name of Environmental Priority Service, Inc. by (signature) PA MTE

Send one white copy to Kansas Department of Health & Environment, Geology Section, 1000 SW Jackson Street, Ste. 420, Topeka, KS 66612-1367. Send one copy to WATER WELL OWNER and retain one for your records.  
 Visit us at <http://www.kdheks.gov/waterwell/index.html> Telephone 785-296-5524.