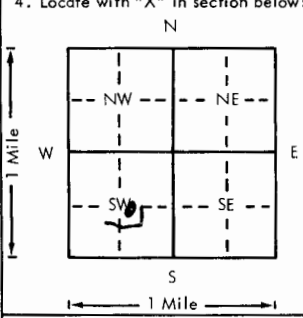
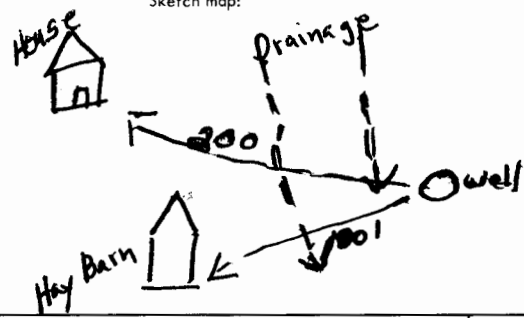


USE TYPEWRITER OR BALL
POINT PEN-PRESS FIRMLY,
PRINT CLEARLY.

WATER WELL RECORD
KSA 82a-1201-1215

Kansas Department of Health and
Environment-Division of Environment
(Water well Contractors)
Topeka, Kansas 66620

1. Location of well:	County Butler	Fraction SE NW 1/4 NE 1/4 SW 1/4	Section number 9	Township number T 28	Range number S R 6 E/W
2. Distance and direction from nearest town or city: 2 mi. S & 1/2 E, 1 3/4 S then 3/4 west of Leon Street address of well location if in city: R. R. # 1 Leon, Kansas 67074			3. Owner of well: Keith Mc Gregor R.R. or street: R. R. # 1 City, state, zip code: Leon, Kansas 67074		
4. Locate with "X" in section below: 			Sketch map: 		
5. Type and color of material			From	To	
Soil			0	2	
Buff Limestone			2	8	
Buff Clay			8	12	
Lime			12	20	
Flint			20	22	
Blueshale			22	28	
Gray Lime, sharp			28	45	
Blueshale			45	50	
White shale-Water			50	53	
Redbed			53	63	
Green shale-Water			63	65	
Blue shale			65	80	
(Use a second sheet if needed)					
18. Elevation: Topography: ____ Hill ____ Slope ____ Upland ☒ Valley	19. Remarks: Keith Mc Gregor will install concrete slab. He knows it is required.		20. Water well contractor's certification: This well was drilled under my jurisdiction and this report is true to the best of my knowledge and belief. 181 Abraham & Plummer Rig 81 A Business name License No. Address R. R. # 1 2 Signed Jay Abraham Date 4-23-79 Authorized representative		

Forward the white, blue and pink copies to the Department of Health and Environment

Numbers on pipe MI6CJ2-MI20 Certain-teed 8" P.V.C. 1120 PIP ; 100 P.S.I.

73.4 SDR51

SCS 432-DASAE-S376

Form WWC-5