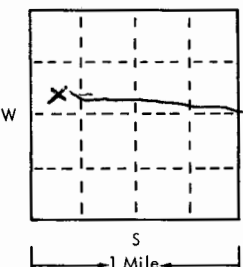
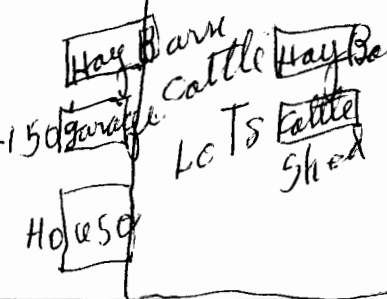


USE TYPEWRITER OR BALL
POINT PEN-PRESS FIRMLY,
PRINT CLEARLY.

WATER WELL RECORD
KSA 82a-1201-1215

3-17-76
T R EW sec 1/4 1/4 1/4 No.

Kansas State Dept. Of Health
(Water Well Contractors)
Forbes-Bldg. 740
Topeka, Kansas 66620

1 Location of well:	County Butler	Township name	Fraction SESWNW	Section number 4	Town number 285	Range number 7E
Distance and direction from nearest town or city: 4 MI. East on		3 Owner of well: Keith Semisch				
Street address of well location if in city: 96 + 1 1/2 M. South		Address: LEON KANE 670 74				
Locate with "X" in section below: 		Sketch map: 		4 Well depth: 105 ft. Date of completion 3-13-76 Well diameter 10 in.		
2 Type and color of material		From		To		5 ☒ Cable tool ☐ Rotary ☐ Driven ☐ Dug ☐ Hollow rod ☐ Jetted ☐ Bored ☐ Reverse rotary
						6 Use: ☒ Domestic ☐ Public supply ☐ Industry ☐ Irrigation ☐ Air conditioning ☐ Commercial ☐ Test well ☐
8" hole reamed to 10"						7 Casing: Material Stirrup Height: above below Threaded ☐ Welded ☐ Surface 16 in. Diam. 6" Weight #200 lbs./ft. 60ft perforated ft. depth Drive shoe? ☐ Yes ☒ No 44 ft. depth
Soil, Clay + Gravel		0		4'		8 Screen: Manufacturer Surfacer Plastics Type RMP Dia. 6" Slot gauge 3/16 Length 65 Set between 40 ft. and 105 ft. Fittings: Gravel pack ☒ Yes ☐ No Size range of material 5/8
Lime, buff		4		20		9 Static water level: 60 ft. below land surface Date 3-15-76
Shale, Blue		20		30		10 Pumping level below land surfaces: ____ ft. after ____ hrs. pumping ____ g.p.m. ____ ft. after ____ hrs. pumping ____ g.p.m. Estimated maximum yield 40 g.p.m.
" " , Blue		30		45		11 Water sample submitted: Will be After ☐ Yes ☒ No Date pump test
White shale		45		50		12 Well head completion: ☐ Pitless adapter 12 ☐ Inches above grade
Green " "		50		53		13 Well grouted? ☒ Yes ☐ No ☒ Neat cement ☐ Bentonite ☐ Depth: From 30 ft. to Ground Level
Redbed		53		58		14 Nearest source of possible contamination: ft 300 Direction SE Type Septic Well disinfected upon completion? ☒ Yes ☐ No
Green shale		58		60		15 Pump: ☒ Not installed Manufacturer's name _____ Model number _____ HP _____ Volts _____ Length of drop pipe _____ ft. capacity _____ g.p.m. Type: ☐ Submersible ☐ Turbine ☐ Jet ☐ Reciprocating ☐ Centrifugal ☐ Other
Lime, white		60		65		17 Water well contractor's certification: This well was drilled under my jurisdiction and this report is true to the best of my knowledge and belief. Abraham Plummer Business name _____ License No. _____ Address Leon Kane 181 Signed Jay Abraham Date 3-15-76 Authorized representative
" " "		65		70		
" " "		70		80		
" " "		80		85		
Shale Blue		85		100		
White shale + Redbed		100		105		
(use a second sheet if needed)						
16 Remarks: elevation						
Topography: ☒ Hill ☐ Slope ☐ Upland ☐ Valley						

Forward the white, blue and pink copies to the Kansas State Dept. Of Health.

Form WWC-5