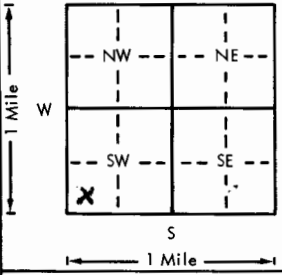
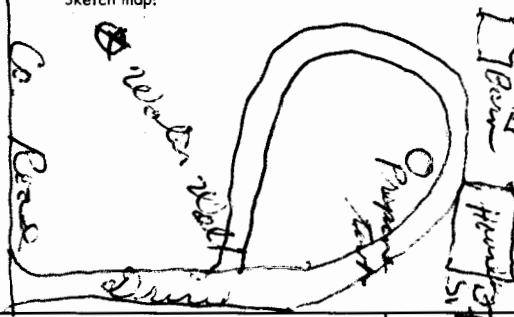


USE TYPEWRITER OR BALL
POINT PEN-PRESS FIRMLY,
PRINT CLEARLY.

WATER WELL RECORD
KSA 82a-1201-1215

Kansas Department of Health and
Environment-Division of Environment
(Water well Contractors)
Topeka, Kansas 66620

1. Location of well:		County <u>Butter</u>	Fraction <u>SW 1/4 SW 1/4 SW 1/4</u>	Section number <u>12</u>	Township number <u>T 28 S</u>	Range number <u>R 7 E</u>
2. Distance and direction from nearest town or city: <u>Salina 1 mi. N.E.</u>		3. Owner of well: <u>James Lambing</u>		R.R. or street: <u>Cruslar</u>		
Street address of well location if in city:		City, state, zip code: <u>Cruslar, 67039</u>				
4. Locate with "X" in section below: 		Sketch map: 		6. Bore hole dia. <u>8</u> in. Completion date <u>9-17-77</u> Well depth <u>195</u> ft.		
5. Type and color of material		From		7. ☒ Cable tool ☐ Rotary ☐ Driven ☐ Dug ☐ Hollow rod ☐ Jetted ☐ Bored ☐ Reverse rotary		
Top soil		0 3'		8. Use: ☒ Domestic ☐ Public supply ☐ Industry ☐ Irrigation ☐ Air conditioning ☐ Stock ☐ Lawn ☐ Oil field water ☐ Other		
Fill gravel		3 10		9. Casing: Material <u>PVC</u> Height <u>Above</u> or below Threaded ☐ Welded ☒ Surface <u>2 1/2</u> in. RMP ☐ PVC ☒ Weight <u>195</u> lbs./ft. Dia. <u>5</u> in. to <u>195</u> ft. depth Wall thickness: inches or Dia. <u>5</u> in. to <u>195</u> ft. depth gage No. <u>0.258</u>		
Clay silty gray		10 25		10. Screen: Manufacturer's name <u>M.P.L.</u> Type <u>M.P.L.</u> Dia. <u>5</u> Slot/gauze <u>25/100</u> Length <u>70</u> Set between <u>185</u> ft. and <u>195</u> ft. Gravel pack? ☒ Size range of material <u>6/8</u>		
Clay gravel M.D. to gray		25 65		11. Static water level: <u>30</u> ft. below land surface Date <u>9-17-77</u>		
Shale compact gray		65 116		12. Pumping level below land surfaces: ____ ft. after ____ hrs. pumping ____ g.p.m. ____ ft. after ____ hrs. pumping ____ g.p.m. Estimated maximum yield <u>3</u> g.p.m.		
White Limestone		116 121		13. Water sample submitted: <u>Yes</u> ☒ No ☐ Date ____		
Shale to silty shale - gray		121 135		14. Well head completion: <u>3</u> inches above grade ☐ Pitless adapter ☒ Inches above grade		
Silty shale to limestone		135 147		15. Well grouted? ☒ With: ☒ Neat cement ☐ Bentonite ☐ Concrete Depth: From <u>0</u> ft. to <u>18</u> ft.		
Limestone to shale - gray		147 160		16. Nearest source of possible contamination: <u>Septic tank</u> ft. <u>400</u> Direction <u>N</u> Type <u>Septic tank</u> Well disinfected upon completion? ☒ Yes ☐ No		
Limestone - white		160 172		17. Pump: ☒ Not installed Manufacturer's name ____ Model number ____ HP ____ Volts ____ Length of drop pipe ____ ft. capacity ____ g.p.m. Type: ☐ Submersible ☐ Turbine ☐ Jet ☐ Reciprocating ☐ Centrifugal ☐ Other		
Shale - gray		172 195		20. Water well contractor's certification: This well was drilled under my jurisdiction and this report is true to the best of my knowledge and belief. <u>Paul Crest Co.</u> Business name <u>Paul Crest Co.</u> License No. <u>353</u> Address <u>Cruslar, 67039</u> Signed <u>Paul Crest</u> Date <u>9-17</u> Authorized representative		
18. Elevation:		19. Remarks: <u>Farmer to construct his pump & covered slab.</u> <u>James Lambing</u>				
Topography: ☒ Hill ☐ Slope ☐ Upland ☐ Valley						

Forward the white, blue and pink copies to the Department of Health and Environment

Form WWC-5