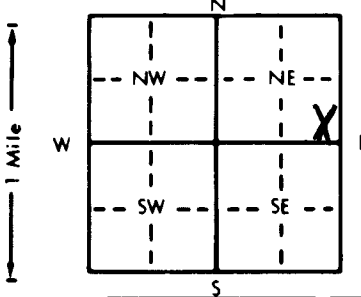


1 LOCATION OF WATER WELL County: <u>Sedgwick</u> Fraction: <u>SE 1/4 SE 1/4 NE 1/4</u> Section Number: <u>9</u> Township Number: <u>T 29 S</u> Range Number: <u>R 1 E</u>					
Distance and direction from nearest town or city street address of well if located within city? <u>See Below</u>					
2 WATER WELL OWNER: <u>Marty Spence</u> RR#, St. Address, Box #: <u>8151 Culu</u> City, State, ZIP Code: <u>Wichita, KS 67233</u> Board of Agriculture, Division of Water Resources Application Number: <u>34</u>					
3 LOCATE WELL'S LOCATION WITH AN "X" IN SECTION BOX: 	4 DEPTH OF COMPLETED WELL: <u>34</u> ft. ELEVATION: <u>8-18-95</u> Depth(s) Groundwater Encountered: <u>10</u> ft. 2. <u>16</u> ft. 3. <u>30</u> ft. WELL'S STATIC WATER LEVEL: <u>10</u> ft. below land surface measured on mo/day/yr <u>30</u> Pump test data: Well water was <u>16</u> ft. after <u>12</u> hours pumping <u>30</u> gpm Est. Yield: <u>30</u> gpm Well water was <u>34</u> ft. after <u>12</u> hours pumping <u>30</u> gpm Bore Hole Diameter: <u>11</u> in. to <u>34</u> ft. and <u>34</u> in. to <u>34</u> ft. WELL WATER TO BE USED AS: 5 Public water supply 8 Air conditioning 11 Injection well 1 Domestic 3 Feedlot 6 Oil field water supply 9 Dewatering 12 Other (Specify below) 2 Irrigation 4 Industrial 7 Lawn and garden only 10 Monitoring well Was a chemical/bacteriological sample submitted to Department? Yes <u>No</u> X If yes, mo/day/yr sample was submitted Water Well Disinfected? Yes <u>X</u> No				
5 TYPE OF BLANK CASING USED: 1 Steel 3 RMP (SR) 5 Wrought iron 8 Concrete tile CASING JOINTS: Glued <u>X</u> Clamped 2 PVC 4 ABS 6 Asbestos-Cement 9 Other (specify below) Welded Blank casing diameter: <u>5</u> in. to <u>12</u> ft. Dia. <u>2.60</u> in. to <u>160</u> psi ft. Casing height above land surface: <u>12</u> in., weight <u>2.60</u> lbs./ft. Wall thickness or gauge No. <u>160</u> psi TYPE OF SCREEN OR PERFORATION MATERIAL: 1 Steel 3 Stainless steel 5 Fiberglass 7 RVC 10 Asbestos-cement 2 Brass 4 Galvanized steel 6 Concrete tile 9 ABS 11 Other (specify) 12 None used (open hole) SCREEN OR PERFORATION OPENINGS ARE: 1 Continuous slot 3 Mill slot 5 Gauzed wrapped 8 Saw cut 11 None (open hole) 2 Louvered shutter 4 Key punched 6 Wire wrapped 9 Drilled holes 10 Other (specify) SCREEN-PERFORATED INTERVALS: From <u>27</u> ft. to <u>34</u> ft. From <u>27</u> ft. to <u>34</u> ft. GRAVEL PACK INTERVALS: From <u>16</u> ft. to <u>34</u> ft. From <u>16</u> ft. to <u>34</u> ft.					
6 GROUT MATERIAL: <u>3</u> Neat cement <u>2</u> Cement grout 3 Bentonite 4 Other Grout Intervals: From <u>3</u> ft. to <u>16</u> ft. From <u>16</u> ft. to <u>34</u> ft. From <u>34</u> ft. to <u>34</u> ft. What is the nearest source of possible contamination: 1 Septic tank 4 Lateral lines 7 Pit privy 10 Livestock pens 14 Abandoned water well 2 Sewer lines 5 Cess pool 8 Sewage lagoon 11 Fuel storage 15 Oil well/Gas well 3 Watertight sewer lines 6 Sewage pit 9 Feedyard 12 Fertilizer storage 16 Other (specify below) 13 Insecticide storage Direction from well? <u>West</u> How many feet? <u>110</u>					
FROM	TO	LITHOLOGIC LOG	FROM	TO	PLUGGING INTERVALS
0	2	Top soil			
2	14	clay			
14	20	fine sand			
20	21	clay			
21	34	gravel			
7 CONTRACTOR'S OR LANDOWNER'S CERTIFICATION: This water well was (1) constructed, (2) reconstructed, or (3) plugged under my jurisdiction and was completed on (mo/day/year) <u>8-18-95</u> and this record is true to the best of my knowledge and belief. Kansas Water Well Contractor's License No. <u>318</u> This Water Well Record was completed on (mo/day/yr) <u>8-24-95</u> under the business name of <u>Weninger Drilling</u> by (signature) <u>HARRINA MORRIS</u>					