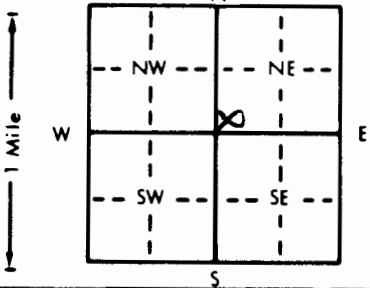


1 LOCATION OF WATER WELL: County: <u>Sedg</u>	Fraction <u>SW 1/4 SW 1/4 NE 1/4</u>	Section Number <u>9</u>	Township Number <u>T 29 S</u>	Range Number <u>R 1 E/W</u>
--	---	----------------------------	----------------------------------	--------------------------------

Distance and direction from nearest town or city street address of well if located within city?

2 WATER WELL OWNER: <u>MORRISON CONST.</u> RR#, St. Address, Box # : <u>1230 E 82ND S.</u> City, State, ZIP Code : <u>Wich KS</u>	Board of Agriculture, Division of Water Resources Application Number:
---	--

3 LOCATE WELL'S LOCATION WITH AN "X" IN SECTION BOX: 	4 DEPTH OF COMPLETED WELL: <u>30</u> ft. ELEVATION: <u>1100</u> Depth(s) Groundwater Encountered 1. <u>12</u> ft. 2. <u>30</u> ft. 3. <u>ft.</u> WELL'S STATIC WATER LEVEL <u>ft.</u> below land surface measured on mo/day/yr Pump test data: Well water was <u>ft.</u> after <u>hours</u> pumping <u>gpm</u> Est. Yield <u>gpm</u> : Well water was <u>ft.</u> after <u>hours</u> pumping <u>gpm</u> Bore Hole Diameter <u>10</u> in. to <u>30</u> ft. and <u>in.</u> to <u>ft.</u> WELL WATER TO BE USED AS: 5 Public water supply 8 Air conditioning 11 Injection well ① Domestic 3 Feedlot 6 Oil field water supply 9 Dewatering 12 Other (Specify below) 2 Irrigation 4 Industrial 7 Lawn and garden only 10 Monitoring well Was a chemical/bacteriological sample submitted to Department? Yes <u>No</u> If yes, mo/day/yr sample was submitted Water Well Disinfected? Yes <u>Y</u> No
--	--

5 TYPE OF BLANK CASING USED: 1 Steel 3 RMP (SR) 5 Wrought iron 8 Concrete tile ② PVC 4 ABS 6 Asbestos-Cement 9 Other (specify below) Blank casing diameter <u>5</u> in. to <u>20</u> ft. Dia. <u>1604</u> in. to <u>ft.</u> Dia. <u>in.</u> to <u>ft.</u> Casing height above land surface <u>12</u> in. weight <u>1604</u> lbs./ft. Wall thickness or gauge No. <u>SOUL</u> TYPE OF SCREEN OR PERFORATION MATERIAL: 1 Steel 3 Stainless steel 5 Fiberglass 8 RMP (SR) 10 Asbestos-cement 2 Brass 4 Galvanized steel 6 Concrete tile 9 ABS 11 Other (specify) 12 None used (open hole) SCREEN OR PERFORATION OPENINGS ARE: 1 Continuous slot 3 Mill slot 5 Gauzed wrapped 8 Saw cut 11 None (open hole) 2 Louvered shutter 4 Key punched 6 Wire wrapped 9 Drilled holes 10 Other (specify) SCREEN-PERFORATED INTERVALS: From <u>20</u> ft. to <u>30</u> ft. From <u>ft.</u> to <u>ft.</u> From <u>ft.</u> to <u>ft.</u> From <u>ft.</u> to <u>ft.</u> GRAVEL PACK INTERVALS: From <u>30</u> ft. to <u>15</u> ft. From <u>ft.</u> to <u>ft.</u> From <u>ft.</u> to <u>ft.</u> From <u>ft.</u> to <u>ft.</u>
--

6 GROUT MATERIAL: 1 Neat cement 2 Cement grout 3 Bentonite 4 Other Grout Intervals: From <u>2</u> ft. to <u>15</u> ft. From <u>ft.</u> to <u>ft.</u> From <u>ft.</u> to <u>ft.</u> What is the nearest source of possible contamination: 1 Septic tank 4 Lateral lines 7 Pit privy 10 Livestock pens 14 Abandoned water well 2 Sewer lines 5 Cess pool 8 Sewage lagoon 11 Fuel storage 15 Oil well/Gas well 3 Watertight sewer lines 6 Seepage pit 9 Feedyard 12 Fertilizer storage 16 Other (specify below) 13 Insecticide storage Direction from well? <u>None noted</u> How many feet? <u>None noted</u>

FROM	TO	LITHOLOGIC LOG	FROM	TO	PLUGGING INTERVALS
0	2	TOP SOIL			
2	10	FINE SAND			
10	18	MED SAND			
18	30	COARSE SAND			

7 CONTRACTOR'S OR LANDOWNER'S CERTIFICATION: This water well was (1) constructed, (2) reconstructed, or (3) plugged under my jurisdiction and was completed on (mo/day/year) <u>5-22-96</u> and this record is true to the best of my knowledge and belief. Kansas Water Well Contractor's License No. <u>463</u> This Water Well Record was completed on (mo/day/yr) <u>6-26-96</u> under the business name of <u>RCA</u> by (signature) <u>Dave Smith</u>
