


1 LOCATION OF WATER WELL: Sedgwick	FRACTION <i>SE SE SE NW</i> SW 1/4 SW 1/4 NE 1/4	Section Number 11	Township Number T 29 S	Range Number R 1E EW
--	--	-----------------------------	----------------------------------	--------------------------------

Distance and direction from nearest town or city street address of well if located within city?

Northeast corner of Hancock and Washington Derby, KS.

WATER WELL OWNER: LEWIS, Thomas	Board of Agriculture, Division of Water Resource
RR#, ST. ADDRESS, BOX #: 8358 Hancock	Application Number:
CITY, STATE, ZIP CODE: Derby, Kansas	

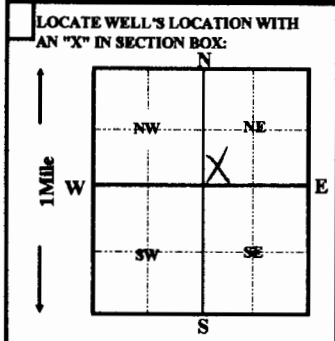

4 DEPTH OF COMPLETED WELL 33 ft.	ELEVATION:
Depth(s) groundwater Encountered 1 ft. 2 ft. 3 ft.	
WELL'S STATIC WATER LEVEL 12 FT. BELOW LAND SURFACE MEASURED ON <i>mo/day/yr</i> 11/27/1996	
Pump test data: Well water was _____ ft. after _____ hours pumping _____ gpm	
Est. Yield gpm: Well water was _____ ft. after _____ hours pumping _____ gpm	
Bore Hole Diameter 12 in. to 33 ft. and _____ in. to _____ ft.	
WELL WATER TO BE USED AS:	
1 Domestic 3 Feedlot 6 Oil field water supply 9 Dewatering 12 Other (Specify below)	
2 Irrigation 4 Industrial 7 Lawn and garden only 10 Monitoring well	
Was a chemical/bacteriological sample submitted to Department? Yes _____ No X ; If yes, mo/day/yr sample was submitted _____	Water Well Disinfected? Yes X No _____

5 TYPE OF CASING USED:	5 Wrought iron	8 Concrete tile	CASING JOINTS: Glued X Clamped
1 Steel	3 RMP (SR)	6 Asbestos-Cement	9 Other (Specify below)
2 PVC	4 ABS	7 Fiberglass	SDR-26
Blank casing Diameter 5 in. to 25 ft., Dia _____ in. to _____ ft.			
Casing height above land surface 12 in., weight 2.35 lbs. / ft.			Wall thickness or gauge No. .214
TYPE OF SCREEN OR PERFORATION MATERIAL:			
1 Steel	3 Stainless Steel	5 Fiberglass	8 RMP (SR)
2 Brass	4 Galvanized steel	6 Concrete tile	9 ABS
SCREEN OR PERFORATION OPENING ARE:			
1 Continuous slot	3 Mill slot	5 Gauzed wrapped	8 Saw cut
2 Louvered shutter	4 Key punched	6 Wire wrapped	9 Drilled holes
		7 Torch cut	10 Other (specify)
SCREEN-PERFORATION INTERVALS: from 25 ft. to 33 ft., From _____ ft. to _____ ft.			
GRAVEL PACK INTERVALS: from 24 ft. to 33 ft., From _____ ft. to _____ ft.			

6 GROUT MATERIAL: 1 Neat cement	2 Cement grout	3 Bentonite	4 Other
Grout Intervals: From 4 ft. to 24 ft. From _____ ft. to _____ ft.			
What is the nearest source of possible contamination:			
1 Septic tank	4 Lateral lines	7 Pit privy	10 Livestock pens
2 Sewer lines	5 Cess pool	8 Sewage lagoon	11 Fuel storage
3 Watertight sewer lines	6 Seepage pit	9 Feedyard	12 Fertilizer storage
			13 Insecticide storage
			14 Abandon water well
			15 Oil well/Gas well
			16 Other (specify below)

Direction from well? **East** How many feet? **75**

FROM	TO	LITHOLOGIC LOG	FROM	TO	PLUGGING INTERVALS
0	2	topsoil			
2	15	clay			
15	23	medium to coarse sand			
23	33	blue shale			

7 CONTRACTOR'S OR LANDOWNER'S CERTIFICATION: This water well was (1) constructed, (2) reconstructed, or (3) plugged under my jurisdiction and was completed on (mo/day/year) **11/27/1996** and this record is true to the best of my knowledge and belief. Kansas Water Well Contractor's License No. **236** This Water Well Record was completed on (mo/day/yr) **12/09/96** Under the business name of **Harp Well & Pump Service, Inc.** by signature *Todd S. Harp*