


1 LOCATION OF WATER WELL: County: Sedgwick Fraction: 3/4 1/4 NE 1/4 Section Number: 1 Township Number: T 29 S Range Number: R 18 E/W

Distance and direction from nearest town or city street address of well if located within city? See below 1 EAST

2 WATER WELL OWNER: Derby Post Office
 RR#, St. Address, Box #: 20 W. Greenwood
 City, State, ZIP Code: Derby, KS. 67037
 Board of Agriculture, Division of Water Resources
 Application Number:

3 LOCATE WELL'S LOCATION WITH AN "X" IN SECTION BOX: NE
 4 DEPTH OF COMPLETED WELL: 81 ft. ELEVATION:

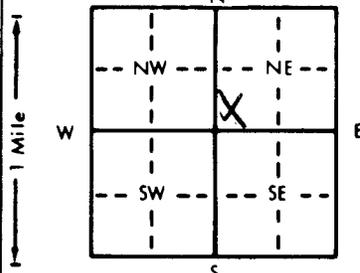

Depth(s) Groundwater Encountered 1. ft. 2. ft. 3. ft.
 WELL'S STATIC WATER LEVEL 57 ft. below land surface measured on mo/day/yr 2-18-97
 Pump test data: Well water was ft. after hours pumping gpm
 Est. Yield 30 gpm; Well water was ft. after hours pumping gpm
 Bore Hole Diameter: 11 in. to 81 in. to in. to in.
 WELL WATER TO BE USED AS:
 5 Public water supply 8 Air conditioning 11 Injection well
 1 Domestic 3 Feedlot 6 Oil field water supply 9 Dewatering 12 Other (Specify below)
 2 Irrigation 4 Industrial 7 Lawn and garden only 10 Monitoring well
 Was a chemical/bacteriological sample submitted to Department? Yes No X; If yes, mo/day/yr sample was sub-
 mitted Water Well Disinfected? Yes X No

5 TYPE OF BLANK CASING USED:
 1 Steel 3 RMP (SR) 5 Wrought iron 8 Concrete tile CASING JOINTS: Glued X Clamped
2 PVC 4 ABS 6 Asbestos-Cement 9 Other (specify below) Welded
 7 Fiberglass Threaded

Blank casing diameter 5 in. to 61 in. Dia. 2.40 in. to ft. Dia. in. to ft.
 Casing height above land surface 12 in. weight lbs./ft. Wall thickness or gauge No. 160 PSE

TYPE OF SCREEN OR PERFORATION MATERIAL:
 1 Steel 3 Stainless steel 5 Fiberglass 7 PVC 10 Asbestos-cement
 2 Brass 4 Galvanized steel 6 Concrete tile 8 RMP (SR) 11 Other (specify)
 12 None used (open hole)

SCREEN OR PERFORATION OPENINGS ARE:
 1 Continuous slot 3 Mill slot 5 Gauzed wrapped 8 Saw cut 11 None (open hole)
 2 Louvered shutter 4 Key punched 6 Wire wrapped 9 Drilled holes
 7 Torch cut 10 Other (specify)

SCREEN-PERFORATED INTERVALS: From 61 ft. to 81 ft. From ft. to ft.
 From ft. to ft. From ft. to ft.
 GRAVEL PACK INTERVALS: From 57 ft. to 81 ft. From ft. to ft.
 From ft. to ft. From ft. to ft.

6 GROUT MATERIAL: 3 1 Neat cement 57 2 Cement grout 3 Bentonite 4 Other
 Grout intervals: From 3 ft. to 57 ft. From ft. to ft. From ft. to ft.

What is the nearest source of possible contamination:
 1 Septic tank 4 Lateral lines 7 Pit privy 10 Livestock pens 14 Abandoned water well
 2 Sewer lines 5 Cess pool 8 Sewage lagoon 11 Fuel storage 15 Oil well/Gas well
3 Watertight sewer lines 6 Seepage pit 9 Feedyard 12 Fertilizer storage 16 Other (specify below)
 13 Insecticide storage
 Direction from well? Southeast How many feet? 15

FROM	TO	LITHOLOGIC LOG	FROM	TO	PLUGGING INTERVALS
0	55	clay			
55	60	fine sand			
60	70	medium sand			
70	81	shale			

7 CONTRACTOR'S OR LANDOWNER'S CERTIFICATION: This water well was (1) constructed, (2) reconstructed, or (3) plugged under my jurisdiction and was completed on (mo/day/year) 2-20-97 and this record is true to the best of my knowledge and belief. Kansas Water Well Contractor's License No. 318. This Water Well Record was completed on (mo/day/yr) 2-20-97 under the business name of Weninger Drilling, Inc. by (signature) Nichole Becker