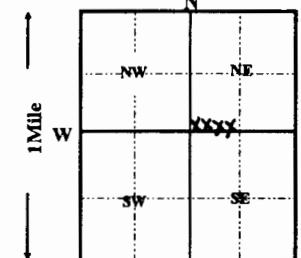


1 LOCATION OF WATER WELL: Sedgwick		FRACTION 1/4 1/4 W 1/2		Section Number 4		Township Number T 29 S		Range Number R 1E E/W	
Distance and direction from nearest town or city street address of well if located within city? S. Brook and Broadway (US 81 Highway) Haysville, Kansas									
WATER WELL OWNER: HAYSVILLE, CITY OF RR#, ST. ADDRESS, BOX #: P.O. Box 404, 200 W. Grand CITY, STATE, ZIP CODE: Haysville, Kansas 67060 Board of Agriculture, Division of Water Resource Application Number: 980123									
LOCATE WELL'S LOCATION WITH AN "X" IN SECTION BOX: 		4 DEPTH OF WELL 45 ft. ELEVATION: Depth(s) groundwater encountered 1 ft. 2 ft. 3 ft. WELL'S STATIC WATER LEVEL 12 FT. BELOW LAND SURFACE MEASURED ON 10/15/1998 Pump test data: Well water was _____ ft. after _____ hours pumping _____ gpm Est. Yield _____ gpm: Well water was _____ ft. after _____ hours pumping _____ gpm Bore Hole Diameter 12 in. to _____ ft. and _____ in. to _____ ft. WELL WATER TO BE USED AS: 5 Public water supply 8 Air conditioning 11 Injection well 1 Domestic 3 Feedlot 6 Oil field water supply 9 Dewatering 12 Other (Specify below) 2 Irrigation 4 Industrial 7 Lawn and garden only 10 Monitoring well Was a chemical/bacteriological sample submitted to Department? Yes _____ No X ; if yes, mo/day/yr sample was submitted _____ Water Well Disinfected? Yes X No _____							
5 TYPE OF CASING USED: 1 Steel 3 RMP (SR) 5 Wrought iron 8 Concrete tile CASING JOINTS: Glued Clamped 2 PVC 4 ABS 6 Asbestos-Cement 9 Other (Specify below) Welded Blank casing Diameter 8 in. to _____ ft., Dia _____ in. to _____ ft., Dia _____ in. to _____ ft. Casing height below land surface 36 in., weight _____ lbs. / ft. Wall thickness or gauge No. _____ TYPE OF SCREEN OR PERFORATION MATERIAL: 1 Steel 3 Stainless Steel 5 Fiberglass 8 RMP (SR) 11 other (specify) N/A 2 Brass 4 Galvanized steel 6 Concrete tile 9 ABS 12 None used (open hole) SCREEN OR PERFORATION OPENING ARE: 1 Continuous slot 3 Mill slot 5 Gauzed wrapped 8 Saw cut 11 None (open hole) 2 Louvered shutter 4 Key punched 6 Wire wrapped 9 Drilled holes 7 Torch cut 10 Other (specify) N/A SCREEN-PERFORATION INTERVALS: from _____ ft. to _____ ft., From _____ ft. to _____ ft. GRAVEL PACK INTERVALS: from _____ ft. to _____ ft., From _____ ft. to _____ ft.									
6 GROUT MATERIAL: 1 Neat cement 2 Cement grout 3 Bentonite 4 Other bentonite hole plug Grout Intervals: From 3 ft. to 6 ft. From _____ ft. to _____ ft. From 6 ft. to 12 ft. What is the nearest source of possible contamination: 1 Septic tank 4 Lateral lines 7 Pit privy 10 Livestock pens 14 Abandon water well 2 Sewer lines 5 Cess pool 8 Sewage lagoon 11 Fuel storage 15 Oil well/Gas well 3 Watertight sewer lines 6 Seepage pit 9 Feedyard 12 Fertilizer storage 16 Other (specify below) 13 Insecticide storage None Apparent Direction from well? _____ How many feet? _____									
FROM TO LITHOLOGIC LOG		FROM TO PLUGGING INTERVALS							
		0 3		surface clay and silt					
		3 6		cement grout					
		6 12		bentonite hole plug					
		12 45		chlorinated sand and gravel					
7 CONTRACTOR'S OR LANDOWNER'S CERTIFICATION: This water well was (1) constructed, (2) reconstructed, or (3) plugged under my jurisdiction and was completed on (mo/day/year) 10/15/1998 and this record is true to the best of my knowledge and belief. Kansas Water Well Contractor's License No. 236 This Water Well Record was completed on (mo/day/yr) 10/19/98 Under the business name of Harp Well & Pump Service, Inc. by (signature) Todd S. Harp									