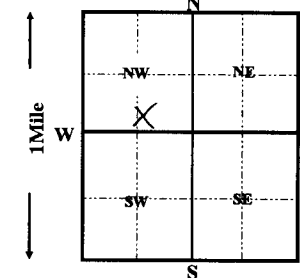


1 LOCATION OF WATER WELL:		FRACTION		Section Number		Township Number		Range Number	
Sedgwick		NW NE SW NW		16		T 29 S		R 1E E/W	
Distance and direction from nearest town or city street address of well if located within city?									
500 Gordon Bennett Haysville, Kansas									
WATER WELL OWNER: LANGE HOMES									
RR#, ST. ADDRESS, BOX #: 500 Gordon Bennett									
CITY, STATE, ZIP CODE: Haysville, Kansas									
Application Number:									
LOCATE WELL'S LOCATION WITH AN "X" IN SECTION BOX:		4 DEPTH OF COMPLETED WELL		35 ft.		ELEVATION:			
		Depth(s) groundwater Encountered		1 ft.		2 ft.		3 ft.	
		WELL'S STATIC WATER LEVEL		15		FT. BELOW LAND SURFACE MEASURED ON		08/31/1999	
		Pump test data:		Well water was		ft. after		hours pumping	
		Est. Yield		gpm: Well water was		ft. after		hours pumping	
		Bore Hole Diameter		12 in. to 35		ft. and		in. to	
		WELL WATER TO BE USED AS:		5 Public water supply		8 Air conditioning		11 Injection well	
		1 Domestic		3 Feedlot		6 Oil field water supply		9 Dewatering	
		2 Irrigation		4 Industrial		7 Lawn and garden only		10 Monitoring well	
		Was a chemical/bacteriological sample submitted to Department? Yes		No		X		If yes, mo/day/yr sample was	
		submitted		Water Well Disinfected?		Yes		X No	
5 TYPE OF CASING USED:									
1 Steel 3 RMP (SR) 5 Wrought iron 8 Concrete tile CASING JOINTS: Glued X Clamped									
2 PVC 4 ABS 6 Asbestos-Cement 9 Other (Specify below) Welded									
Blank casing Diameter 5 in. to 25 ft., Dia. in. to ft., Dia. in. to ft. SDR-26 Threaded									
Casing height above land surface 12 in., weight 2.35 lbs./ft. Wall thickness or gauge No. .214									
TYPE OF SCREEN OR PERFORATION MATERIAL:									
1 Steel 3 Stainless Steel 5 Fiberglass 8 RMP (SR) 11 other (specify)									
2 Brass 4 Galvanized steel 6 Concrete tile 9 ABS 12 None used (open hole)									
SCREEN OR PERFORATION OPENING ARE:									
1 Continuous slot 3 Mill slot 5 Gauzed wrapped 8 Saw cut 11 None (open hole)									
2 Louvered shutter 4 Key punched 6 Wire wrapped 9 Drilled holes									
7 Torch cut 10 Other (specify)									
SCREEN-PERFORATION INTERVALS: from 25 ft. to 35 ft., From ft. to ft.									
GRAVEL PACK INTERVALS: from 26 ft. to 35 ft., From ft. to ft.									
6 GROUT MATERIAL: 1 Neat cement 2 Cement grout 3 Bentonite 4 Other bentonite hole plug									
Grout Intervals: From 4 ft. to 24 ft. From ft. to ft. From 24 ft. to 25 ft.									
What is the nearest source of possible contamination:									
1 Septic tank 4 Lateral lines 7 Pit privy 10 Livestock pens 14 Abandon water well									
2 Sewer lines 5 Cess pool 8 Sewage lagoon 11 Fuel storage 15 Oil well/Gas well									
3 Watertight sewer lines 6 Seepage pit 9 Feedyard 12 Fertilizer storage 16 Other (specify below)									
13 Insecticide storage									
Direction from well? North How many feet? 90									
FROM TO LITHOLOGIC LOG FROM TO PLUGGING INTERVALS									
0 2 fine sand									
2 6 clay									
6 35 medium coarse sand									
7 CONTRACTOR'S OR LANDOWNER'S CERTIFICATION: This water well was (1) constructed, (2) reconstructed, or (3) plugged under my jurisdiction and was completed on (mo/day/year) 08/31/1999 and this record is to the best of my knowledge and belief. Kansas Water Well Contractor's License No. 236 This Water Well Record was completed on (mo/day/yr) 09/01/99 Under the business name of Harp Well & Pump Service, Inc. by (signature) Todd S. Harp									