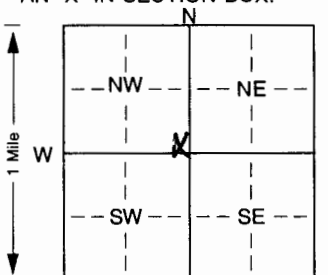


01-7146

WATER WELL RECORD Form WWC-5 KSA 82a-1212 ID No.

MW-106

1 LOCATION OF WATER WELL:		Fraction	Section Number	Township Number	Range Number
County: <u>Sedgwick</u>		<u>SE 1/4 SE 1/4 NW 1/4</u>	<u>4</u>	T <u>29</u> S	R <u>1</u> EW
Distance and direction from nearest town or city street address of well if located within city? <u>East side of I-35 south of 71st st. Derby</u>					
2 WATER WELL OWNER: <u>Kansas Corporation Commission</u>					
RR#, St. Address, Box # : <u>130 S. Market Rm 2125</u>				Board of Agriculture, Division of Water Resources	
City, State, ZIP Code : <u>Wichita KS 67202</u>				Application Number:	

		Was a chemical/bacteriological sample submitted to Department? Yes <u>No</u> <u>X</u> ; If yes, mo/day/yr sample was submitted Water Well Disinfected? Yes <u>No</u> <u>X</u>			
5 TYPE OF BLANK CASING USED:					
1 Steel		3 RMP (SR)		5 Wrought iron	
<u>2 PVC</u>		4 ABS		6 Asbestos-Cement	
				7 Fiberglass	
Casing height above land surface <u>Flush</u> in., weight <u>70.3</u> lbs./ft. Wall thickness or gauge No. <u>Sch 40</u>		9 Other (specify below)		Welded <u>Threaded</u> <u>Flush</u>	
TYPE OF SCREEN OR PERFORATION MATERIAL:					
1 Steel		3 Stainless steel		5 Fiberglass	
2 Brass		4 Galvanized steel		6 Concrete tile	
SCREEN OR PERFORATION OPENINGS ARE:		5 Gauzed wrapped		8 Saw cut	
1 Continuous slot		6 Wire wrapped		9 Drilled holes	
2 Louvered shutter		7 Torch cut		10 Other (specify) <u>ft.</u>	
3 Mill slot		8 RMP (SR)		11 None (open hole)	
4 Key punched		9 ABS		12 None used (open hole)	
6 GROUT MATERIAL:					
1 Neat cement		2 Cement grout		3 Bentonite	
4 Other					
Grout Intervals: From <u>2</u> ft. to <u>6</u> ft., From <u>22</u> ft. to <u>28</u> ft., From <u>28</u> ft. to <u>43.3</u> ft.					
What is the nearest source of possible contamination:					
1 Septic tank		4 Lateral lines		7 Pit privy	
2 Sewer lines		5 Cess pool		8 Sewage lagoon	
3 Watertight sewer lines		6 Seepage pit		9 Feedyard	
				10 Livestock pens	
				11 Fuel storage	
				12 Fertilizer storage	
				13 Insecticide storage	
				14 Abandoned water well	
				15 Oil well/Gas well	
				16 Other (specify below)	
Direction from well? <u>How many feet?</u>					
FROM	TO	LITHOLOGIC LOG	FROM	TO	PLUGGING INTERVALS
0	2	Sandy clay, br			
2	9	Sand, f to c			
9	42	Sand, m to vc			
42	43.3	Shale, weathered, dk gray			
7 CONTRACTOR'S OR LANDOWNER'S CERTIFICATION: This water well was (1) constructed (2) reconstructed, or (3) plugged under my jurisdiction and was completed on (mo/day/year) <u>4/30/02</u> and this record is true to the best of my knowledge and belief. Kansas Water Well Contractor's Licence No. <u>531</u> This Water Well Record was completed on (mo/day/yr) <u>5/29/02</u> under the business name of <u>Geotechnical Services, Inc.</u> by (signature) <u>Alvin M. Smith</u>					
INSTRUCTIONS: Use typewriter or ball point pen. PLEASE PRESS FIRMLY and PRINT clearly. Please fill in blanks, underline or circle the correct answers. Send top three copies to Kansas Department of Health and Environment, Bureau of Water, Topeka, Kansas 66620-0001. Telephone 785-296-5524. Send one to WATER WELL OWNER and retain one for your records. Fee of \$5.00 for each constructed well.					