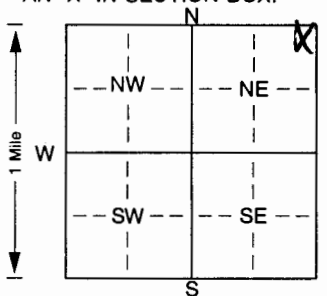


017146

WATER WELL RECORD Form WWC-5 KSA 82a-1212 ID No.

MW-103

1 LOCATION OF WATER WELL:		Fraction	Section Number	Township Number	Range Number
County: <u>Sedgewick</u>		<u>NE 1/4 NE 1/4 NE 1/4</u>	<u>15</u>	T <u>29</u> S	R <u>10</u> E/W
Distance and direction from nearest town or city street address of well if located within city? <u>SW corner of 87th & Hillside, Derby</u>					
2 WATER WELL OWNER:					
RR#, St. Address, Box # : <u>130 S. Market Rm 2125</u> Board of Agriculture, Division of Water Resources					
City, State, ZIP Code : <u>Wichita KS 67202</u> Application Number:					
3 LOCATE WELL'S LOCATION WITH AN "X" IN SECTION BOX:		4 DEPTH OF COMPLETED WELL: <u>39.7</u> ft. ELEVATION:			
		WELL WATER TO BE USED AS: 5 Public water supply 8 Air conditioning 11 Injection well			
		1 Domestic 3 Feedlot 6 Oil field water supply 9 Dewatering 12 Other (Specify below)			
		2 Irrigation 4 Industrial 7 Domestic (lawn & garden) <u>10 Monitoring well</u>			
		Was a chemical/bacteriological sample submitted to Department? Yes. <u>No</u> <u>X</u> ; If yes, mo/day/yr sample was submitted			
		Water Well Disinfected? Yes <u>No</u> <u>X</u>			
5 TYPE OF BLANK CASING USED:					
1 Steel 3 RMP (SR) 5 Wrought iron 8 Concrete tile CASING JOINTS: Glued. <u>Clamped</u>					
2 <u>PVC</u> 4 ABS 6 Asbestos-Cement 9 Other (specify below) Welded <u>Flush</u>					
7 Fiberglass <u>Threaded</u>					
Casing height above land surface <u>Flush</u> in., weight <u>703</u> lbs./ft. Wall thickness or gauge No. <u>Sch 40</u>					
TYPE OF SCREEN OR PERFORATION MATERIAL:					
1 Steel 3 Stainless steel 5 Fiberglass 8 RMP (SR) 10 Asbestos-cement					
2 Brass 4 Galvanized steel 6 Concrete tile 9 ABS 11 Other (specify)					
12 None used (open hole)					
SCREEN OR PERFORATION OPENINGS ARE:					
1 Continuous slot 3 <u>Mill slot</u> 5 Gauzed wrapped 8 Saw cut 11 None (open hole)					
2 Louvered shutter 4 Key punched 6 Wire wrapped 9 Drilled holes					
7 Torch cut 10 Other (specify) <u>10</u> ft.					
6 GROUT MATERIAL: 1 Neat cement 2 Cement grout 3 <u>Bentonite</u> 4 Other					
Grout Intervals: From <u>4</u> ft. to <u>7.5</u> ft., From <u>19</u> ft. to <u>24.5</u> ft., From <u>24.5</u> ft. to <u>24.5</u> ft.					
What is the nearest source of possible contamination:					
1 Septic tank 4 Lateral lines 7 Pit privy 10 Livestock pens 14 Abandoned water well					
2 Sewer lines 5 Cess pool 8 Sewage lagoon 11 Fuel storage 15 Oil well/Gas well					
3 Watertight sewer lines 6 Seepage pit 9 Feedyard 12 Fertilizer storage 16 Other (specify below)					
13 Insecticide storage					
Direction from well? <u>How many feet?</u>					
FROM	TO	LITHOLOGIC LOG	FROM	TO	PLUGGING INTERVALS
0	11	Silty sandy clay - br			
11	23	Sand - f to c grain			
23	39.5	Sand - med to very coarse			
39.5	39.7	Shale, weathered dk grey			
7 CONTRACTOR'S OR LANDOWNER'S CERTIFICATION: This water well was <u>(1) constructed</u> , <u>(2) reconstructed</u> , or <u>(3) plugged</u> under my jurisdiction and was completed on (mo/day/year) <u>4/30/02</u> and this record is true to the best of my knowledge and belief. Kansas					
Water Well Contractor's Licence No. <u>531</u> This Water Well Record was completed on (mo/day/yr) <u>5/29/02</u>					
under the business name of <u>Geotechnical Services, Inc</u> by (signature) <u>Allen M. Smith</u>					
INSTRUCTIONS: Use typewriter or ball point pen. PLEASE PRESS FIRMLY and PRINT clearly. Please fill in blanks, underline or circle the correct answers. Send top three copies to Kansas Department of Health and Environment, Bureau of Water, Topeka, Kansas 66620-0001. Telephone 785-296-5524. Send one to WATER WELL OWNER and retain one for your records. Fee of \$5.00 for each constructed well.					