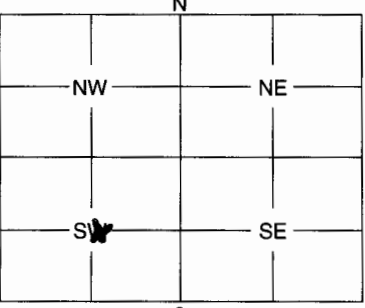


| 1   | LOCATION OF WATER WELL:<br>County: <u>Sedgewick</u>   | Fraction<br><u>1/4 NW 1/4 SW</u> | Section Number<br><u>26</u>   | Township Number<br><u>29</u> | Range Number<br><u>1</u> <span style="float:right;">EW</span> |               |                       
|---|---|----------------------------------|---|------------------------------|---------------------------------------------------------------|---------------|-----------------------|--------------------|------------------------------------------------|--------------------------|-----------------------------------------|-----------------------|----------------------------|--------------------------|-----------------|------------------------|-------------------|-----------------|------------|-------------------------|--|-------------|-------------------|----------------------|--|--|--|--|--|
| Distance and direction from nearest town or city street address of well if located within city?<br><u>From Mulvane, KS: 2 miles West and 1 1/2 miles North</u>   |   |                                  
| 2   | WATER WELL OWNER: <u>Robert H. Chesney</u><br>RR #, St. Address, Box #: <u>PO Box 455</u><br>City, State, ZIP Code: <u>Needles, CA 92363</u>   |                                  |   
| 3<br>MARK WELL'S LOCATION WITH AN "X" IN SECTION BOX:<br><div style="text-align: center; margin-top: 10px;"></div>   |   |                                  | 4<br>DEPTH OF WELL ..... <u>35</u> ..... ft.<br>WELL'S STATIC WATER LEVEL ..... <u>8</u> ..... ft.<br>WELL WAS USED AS:<br><table style="width:100%;"><tr><td>1 Domestic</td><td>5 Public Water Supply</td><td>9 Dewatering</td></tr><tr><td><input checked="" type="checkbox"/> Irrigation</td><td>6 Oil Field Water Supply</td><td>10 Monitoring Well</td></tr><tr><td>3 Feedlot</td><td>7 Domestic (Lawn &amp; Garden)</td><td>11 Injection Well</td></tr><tr><td>4 Industrial</td><td>8 Air Conditioning</td><td>12 Other .....</td></tr>




| Was a chemical / bacteriological sample submitted to Department? Yes ..... No <u>X</u> .....<br>If yes, mo/day/yr sample was submitted .....   |   |                                  | Water Well Disinfected: Yes <u>X</u> No .....   |                              |                                                               
| 5   | TYPE OF BLANK CASING USED:<br><table style="width:100%;"><tr><td>1 Steel</td><td>3 RMP (SR)</td><td>5 Wrought</td><td>7 Fiberglass</td><td>9 Other (Specify below)</td></tr><tr><td><input checked="" type="checkbox"/> PVC</td><td>4 ABS</td><td>6 Asbestos-Cement</td><td>8 Concrete Tile</td><td></td></tr></table><br>Blank casing diameter <u>6 5/8</u> in. Was casing pulled? Yes ..... No <u>X</u> ..... If yes, how much .....<br>Casing height above or below land surface ..... <u>36</u> ..... in.   |                                  |   


| 6   | GROUT PLUG MATERIAL: 1 Neat cement <input checked="" type="checkbox"/> Cement grout 3 Bentonite 4 Other .....<br>Grout Plug Intervals: From <u>3</u> ft. to <u>20</u> ft., From ..... ft. to ..... ft., From ..... to ..... ft.<br>What is the nearest source of possible contamination:<br><table style="width:100%;"><tr><td>1 Septic tank</td><td>6 Seepage pit</td><td>11 Fuel storage</td><td>16 Other (specify below)</td></tr><tr><td>2 Sewer lines</td><td>7 Pit privy</td><td>12 Fertilizer storage</td><td><u>None</u></td></tr><tr><td>3 Watertight sewer lines</td><td>8 Sewage lagoon</td><td>13 Insecticide storage</td><td><u>Open field</u></td></tr><tr><td>4 Lateral lines</td><td>9 Feedyard</td><td>14 Abandoned water well</td><td></td></tr><tr><td>5 Cess pool</td><td>10 Livestock pens</td><td>15 Oil well/Gas well</td><td></td></tr></table><br>Direction from well? ..... How many feet? ..... |                                  |   |                              |                                                               | 1 Septic tank | 





| <table border="1" style="width:100%; border-collapse: collapse;"><thead><tr><th style="width:15%;">FROM</th><th style="width:15%;">TO</th><th style="width:70%;">PLUGGING MATERIALS</th></tr></thead><tbody><tr><td><u>0</u></td><td><u>3</u></td><td><u>Topsoil</u></td></tr><tr><td><u>3</u></td><td><u>20</u></td><td><u>Cement</u></td></tr><tr><td><u>20</u></td><td><u>25</u></td><td><u>Gravel</u></td></tr><tr><td> </td><td> </td><td> </td></tr><tr><td> </td><td> </td><td> </td></tr><tr><td> </td><td> </td><td> </td></tr><tr><td> </td><td> </td><td> </td></tr>




|   |   
| 7   | CONTRACTOR'S OF LANDOWNER'S CERTIFICATION: This water well was plugged under my jurisdiction and was completed on (mo/day/year) <u>4-7-05</u> and this record is true to the best of my knowledge and belief. Kansas Water Well Contractor's License No. <u>238</u> This Water Well Record was completed on (mo/day/year) <u>4-22-05</u> under the business name of <u>Weninger Irrigation</u><br>by (signature) <u>[Signature]</u>   |                                  |   

INSTRUCTIONS: Use typewriter or ball point pen. Please press firmly and print clearly. Please fill in blanks, underline or circle the correct answers. Send top three copies to Kansas Department of Health and Environment, Bureau of Water, Geology Section, 1000 SW Jackson St., Ste. 420, Topeka, Kansas 66612-1367. Telephone: 785/296-5522. Send one to Water Well Owner and retain one for your records.