

1 LOCATION OF WATER WELL: Front 1/4 SE 8th Section Number 17 Township Number 210 S Range Number 10 E
 County: Sedgwick Distance and direction from nearest town or city street address of well if located within city?

130 E. 91st St. Wichita, KS 67233


2 WATER WELL OWNER: Jim Gavin

RR#, St. Address, Box # :
 City, State, ZIP Code

130 E. 91st St. Wichita, KS 67233

Board of Agriculture, Division of Water Resources
 Application Number:

3 LOCATE WELL'S LOCATION WITH AN "X" IN SECTION BOX:

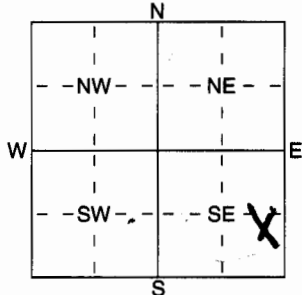

4 DEPTH OF COMPLETED WELL 52 ft. ELEVATION:

Depth(s) Groundwater Encountered 52 ft. 2 ft. 3 ft.
 WELL'S STATIC WATER LEVEL 15 ft. below land surface measured on mo/day/yr


WELL WATER TO BE USED AS:
 1 Domestic 3 Feedlot 6 Oil field water supply 9 Dewatering 12 Other (Specify below)
 2 Irrigation 4 Industrial 7 Domestic (lawn & garden) 10 Monitoring well

Was a chemical/bacteriological sample submitted to Department? Yes No X If yes, mo/day/yr sample was submitted Water Well Disinfected? Yes No

5 TYPE OF BLANK CASING USED:

1 Steel 3 RMP (SR)
 2 PVC 4 ABS

5 Wrought iron 6 Asbestos-Cement
 7 Fiberglass

8 Concrete tile 9 Other (specify below)

CASING JOINTS: Glued X Clamped
 Welded
 Threaded

Blank casing diameter 5 in. to 42 ft., Dia 12 in. to 2.4 lbs./ft. Wall thickness or gauge No. 160 PSI

TYPE OF SCREEN OR PERFORATION MATERIAL:

1 Steel 3 Stainless Steel
 2 Brass 4 Galvanized Steel

5 Fiberglass 8 RMP (SR)
 6 Concrete tile 9 ABS

10 Asbestos-Cement 11 Other (Specify)
 12 None used (open hole)

SCREEN OR PERFORATION OPENINGS ARE:

1 Continuous slot 5 Mill slot
 2 Louvered shutter 4 Key punched

5 Gauzed wrapped 8 Saw cut
 6 Wire wrapped 9 Drilled holes
 7 Torch cut 10 Other (specify)

11 None (open hole)

SCREEN-PERFORATED INTERVALS: From 42 ft. to 52 ft., From 15 ft. to 52 ft.

GRAVEL PACK INTERVALS: From 15 ft. to 52 ft., From 15 ft. to 52 ft.

6 GROUT MATERIAL:

1 Neat cement 15 Cement grout

3 Bentonite

4 Other

Grout Intervals: From 3 ft. to 15 ft., From 15 ft. to 50 ft.

What is the nearest source of possible contamination:

1 Septic tank 4 Lateral lines
 2 Sewer lines 5 Cess pool
 3 Watertight sewer lines 6 Seepage pit

7 Pit privy 8 Sewage lagoon
 9 Feedyard

10 Livestock pens 14 Abandoned water well
 11 Fuel storage 15 Oil well/Gas well
 12 Fertilizer storage 16 Other (specify below)
 13 Insecticide storage

Direction from well? EAST

How many feet? 50

FROM	TO	LITHOLOGIC LOG	FROM	TO	PLUGGING INTERVALS
0	1	top soil			
1	3	clay			
3	20	fine sand			
20	30	med sand/gravel			
30	41	fine sand			
41	52	med sand			

7 CONTRACTOR'S OR (AND) OWNER'S CERTIFICATION: This water well was (1) constructed, (2) reconstructed, or (3) plugged under my jurisdiction and was completed on (mo/day/year) 6/24/05 and this record is true to the best of my knowledge and belief. Kansas

Water Well Contractor's Licence No. #740 This Water Well Record was completed on (mo/day/yr) 6/24/05 under the business name of Wensinger Drilling Inc. by (signature) Allen Wensinger