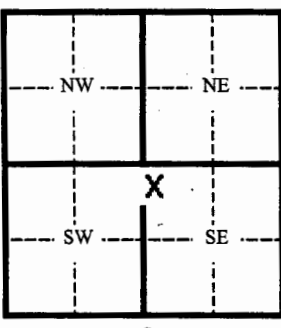
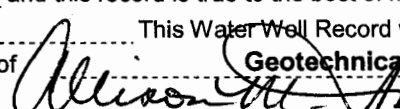


WATER WELL PLUGGING RECORD

Form WWC-5P

KSA 82a-1212

ID No.

1 LOCATION OF WATER WELL:		Fraction	Section Number	Township Number	Range Number																																				
County: Sedgwick		NW ¼ NW ¼ SE ¼	12	29	1 E																																				
Distance and direction from nearest town or city street address of well if located within city? 330 S. Baltimore, Derby, Kansas	
2 WATER WELL OWNER: RR#, St. Address, Box # City, State, ZIP Code :		Total Petrochemicals USA, Inc. 15710 J. F. K. Blvd Houston TX 77067 Board of Agriculture, Division of Water Resources Application Number:																																							
3 MARK WELL'S LOCATION WITH AN "X" IN SECTION BOX: 		4 DEPTH OF WELL 52.17 ft. WELL'S STATIC WATER LEVEL 44.36 ft. WELL WAS USED AS: <table style="width:100%;"><tr><td>1 Domestic</td><td>5 Public Water Supply</td><td>9 Dewatering</td></tr><tr><td>2 Irrigation</td><td>6 Oil Field Water Supply</td><td>10 Monitoring Well</td></tr><tr><td>3 Feedlot</td><td>7 Lawn and Garden (domestic)</td><td>11 Injection Well</td></tr><tr><td>4 Industrial</td><td>8 Air Conditioning</td><td>12 Other</td></tr></table> Was a chemical/bacteriological sample submitted to Department? Yes ___ No X If yes, mo/day/yr sample was submitted _____ Water Well Disinfected: Yes ___ No X				1 Domestic	5 Public Water Supply	9 Dewatering	2 Irrigation	6 Oil Field Water Supply	10 Monitoring Well	3 Feedlot	7 Lawn and Garden (domestic)	11 Injection Well	4 Industrial	8 Air Conditioning	12 Other																								
1 Domestic	5 Public Water Supply	9 Dewatering																																							
2 Irrigation	6 Oil Field Water Supply	10 Monitoring Well																																							
3 Feedlot	7 Lawn and Garden (domestic)	11 Injection Well																																							
4 Industrial	8 Air Conditioning	12 Other																																							
5 TYPE OF BLANK CASING USED: <table style="width:100%;"><tr><td>1 Steel</td><td>3 RMP (SR)</td><td>5 Wrought</td><td>7 Fiberglass</td><td>9 Other (specify below)</td></tr><tr><td>2 PVC</td><td>4 ABC</td><td>6 Asbestos-Cement</td><td>8 Concrete Tile</td><td></td></tr></table> Blank casing diameter 4 in. Was casing pulled? Yes ___ No X If yes, how much _____ Casing height above or <u>below</u> land surface 36 in. Overdrilled to 3 feet below ground surface						1 Steel	3 RMP (SR)	5 Wrought	7 Fiberglass	9 Other (specify below)	2 PVC	4 ABC	6 Asbestos-Cement	8 Concrete Tile																											
1 Steel	3 RMP (SR)	5 Wrought	7 Fiberglass	9 Other (specify below)																																					
2 PVC	4 ABC	6 Asbestos-Cement	8 Concrete Tile																																						
6 GROUT PLUG MATERIAL: 1 Neat cement 2 Cement grout 3 Bentonite 4 Other _____ Grout Plug Intervals From 3 ft. to 52.17 ft. From _____ ft. to _____ ft. From _____ ft. to _____ ft. What is the nearest source of possible contamination: <table style="width:100%;"><tr><td>1 Septic tank</td><td>6 Seepage pit</td><td>11 Fuel storage</td><td>16 Other (specify below)</td></tr><tr><td>2 Sewer lines</td><td>7 Pit privy</td><td>12 Fertilizer storage</td><td></td></tr><tr><td>3 Watertight sewer lines</td><td>8 Sewage lagoon</td><td>13 Insecticide storage</td><td></td></tr><tr><td>4 Lateral lines</td><td>9 Feedyard</td><td>14 Abandoned water well</td><td></td></tr><tr><td>5 Cess Pool</td><td>10 Livestock pens</td><td>15 Oil well/ Gas well</td><td></td></tr></table> Direction from well? _____ How many feet? _____						1 Septic tank	6 Seepage pit	11 Fuel storage	16 Other (specify below)	2 Sewer lines	7 Pit privy	12 Fertilizer storage		3 Watertight sewer lines	8 Sewage lagoon	13 Insecticide storage		4 Lateral lines	9 Feedyard	14 Abandoned water well		5 Cess Pool	10 Livestock pens	15 Oil well/ Gas well																	
1 Septic tank	6 Seepage pit	11 Fuel storage	16 Other (specify below)																																						
2 Sewer lines	7 Pit privy	12 Fertilizer storage																																							
3 Watertight sewer lines	8 Sewage lagoon	13 Insecticide storage																																							
4 Lateral lines	9 Feedyard	14 Abandoned water well																																							
5 Cess Pool	10 Livestock pens	15 Oil well/ Gas well																																							
<table border="1" style="width:100%; border-collapse: collapse;"><thead><tr><th>FROM</th><th>TO</th><th>CODE</th><th>PLUGGING MATERIALS</th></tr></thead><tbody><tr><td>0</td><td>3</td><td></td><td>Concrete</td></tr><tr><td>3</td><td>52.17</td><td></td><td>Bentonite</td></tr><tr><td> </td><td> </td><td> </td><td> </td></tr><tr><td> </td><td> </td><td> </td><td> </td></tr><tr><td> </td><td> </td><td> </td><td> </td></tr><tr><td> </td><td> </td><td> </td><td> </td></tr><tr><td> </td><td> </td><td> </td><td> </td></tr><tr><td> </td><td> </td><td> </td><td> </td></tr></tbody></table>						FROM	TO	CODE	PLUGGING MATERIALS	0	3		Concrete	3	52.17		Bentonite																								
FROM	TO	CODE	PLUGGING MATERIALS																																						
0	3		Concrete																																						
3	52.17		Bentonite																																						
7 CONTRACTOR'S OR LANDOWNER'S CERTIFICATION: This water well was plugged under my jurisdiction and was completed on (mo/day/yr) 5-16-05 and this record is true to the best of my knowledge and belief. Kansas Water Well Contractor's License No. 531 This Water Well Record was completed on (mo/day/yr) 7-18-05 under the business name of Geotechnical Services, Inc. by (signature) 	
INSTRUCTIONS: Please fill in blanks and circle the correct answers. Send three copies to Kansas Department of Health and Environment, Bureau of Water, 1000 S W Jackson St., Ste. 420, Topeka, Kansas 66620-0001. Telephone: 785-296-3565. Send one to Water Well Owner and retain one for your records.	