

1	LOCATION OF WATER WELL:	Fraction	Section Number	Township Number	Range Number
County:	Schlesick	NE 1/4 NE 1/4 NW 1/4	9	T 29 S	R 1 EW

Distance and direction from nearest town or city street address of well if located within city?


8101 South Mead

2	WATER WELL OWNER:	William McPherson
	RR#, St. Address, Box #	8101 South Mend
	City, State, ZIP Code	Haysville KS 67060

Board of Agriculture, Division of Water Resources
Application Number:

3 LOCATE WELL'S LOCATION WITH 4 DEPTH OF COMPLETED WELL 48 ft. ELEVATION:

AN "X" IN SECTION BOX:

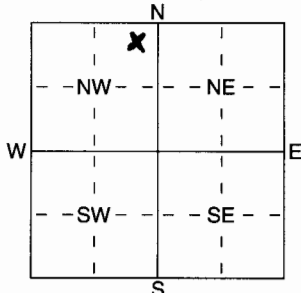

Depth(s) Groundwater Encountered 1 13 ft. 2 _____ ft. 3 _____ ft.

WELL'S STATIC WATER LEVEL 13 ft. below land surface measured on mo/day/yr 4-19-06

Pump test data: Well water was ft. after hours pumping gpm
Est. Yield 40 gpm: Well water was ft. after hours pumping gpm

WELL WATER TO BE USED AS: 5 Public water supply 8 Air conditioning 11 Injection well

1 Domestic 3 Feedlot 6 Oil field water supply 9 Dewatering 12 Other (Specify below)
 2 Irrigation 4 Industrial 7 Domestic (lawn & garden) 10 Monitoring well

Was a chemical/bacteriological sample submitted to Department? Yes No ~~.....~~; If yes, mo/day/hrs sample was submitted
 Water Well Disinfected? Yes ☒ No ☐

5	TYPE OF BLANK CASING USED:
---	----------------------------

1 Steel 3 RMP (SR)
2 PVC 4 ABS

5 Wrought iron
6 Asbestos-Cement
7 Fiberglass

8 Concrete tile
9 Other (specify below)

CASING JOINTS: Glued ~~X~~ Clamped
Welded
Threaded

Blank casing diameter 5 in. to 28 ft. Dia _____ in. to _____ ft. Dia _____ in. to _____ ft.

Casing height above land surface 12 in., weight 2.5 lbs./ft. Wall thickness or gauge No. SA 26

TYPE OF SCREEN OR PERFORATION MATERIAL:

1 Steel	3 Stainless Steel
2 Brass	4 Galvanized Steel

5 Fiberglass
6 Concrete tile

8 RMP (SR)
9 ABS

10 Asbestos-Cement
11 Other (Specify)
12 None used (open hole)

SCREEN OR PERFORATION OPENINGS ARE:

1 Continuous slot	3 Mill slot
2 Louvered shutter	4 Key punched

5 Guazed wrapped
6 Wire wrapped
7 Torch cut

☒ Saw cut
 ☐ 11 None (open hole)

☐ 9 Drilled holes

☐ 10 Other (specify) ft.

SCREEN-PERFORATED INTERVALS: From 28 ft. to 48 ft., From _____ ft. to _____ ft.
From _____ ft. to _____ ft. From _____ ft. to _____ ft.

GRAVEL PACK INTERVALS: From 30 ft. to 48 ft. From _____ ft. to _____ ft.
From _____ ft. to _____ ft. From _____ ft. to _____ ft.

6 GROUT MATERIAL: 1 Neat cement 2 Cement grout 3 Bentonite 4 Other.....
Grout Intervals: From 3 ft. to 20 ft. From ft. to ft. From ft. to ft.

What is the nearest source of possible contamination:

1 Septic tank	4 Lateral lines	7 Pit privy	10 Fertilizer storage	15 Fuel well/Gas well
2 Sewer lines	5 Cess pool	8 Sewage lagoon	12 Fertilizer storage	16 Other (specify below)
3 Watertight sewer lines	6 Seepage pit	9 Feedyard	13 Insecticide storage	

Direction from well? North How many feet? 70

[illegible]

7 CONTRACTOR'S OR LANDOWNER'S CERTIFICATION: This water well was (1) constructed, (2) reconstructed, or (3) plugged under my jurisdiction and was completed on (mo/day/year) 4-19-06 and this record is true to the best of my knowledge and belief. Kansas Water Well Contractor's Licence No. 238 This Water Well Record was completed on (mo/day/yr) 4-20-06 under the business name of Water & Drilling Consultants, Inc. by (signature) [Signature]