


WATER WELL RECORD Form WWC-5

Division of Water Resources App. No. Well ID

Original Record Correction Change in Well Use

1 LOCATION OF WATER WELL:
 County: Sedgewick Fraction NE 1/4 SW 1/4 SW 1/4 Section Number 6 Township Number T 29 S Range Number R 1 E

2 WELL OWNER: Last Name: Custom Touch Lawn First: Hayville
 Business: Custom Touch Lawn Street or Rural Address where well is located (if unknown, distance and direction from nearest town or intersection): If at owner's address, check here:
 Address: 915 S. Melvin Ct.
 City: Hayville State: KS ZIP: 67060

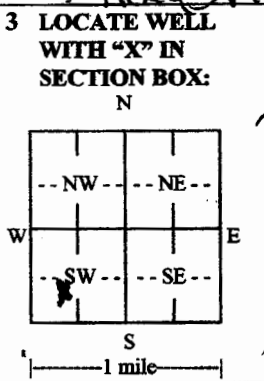

4 DEPTH OF COMPLETED WELL: 56 ft.
 Depth(s) Groundwater Encountered: 1) 25 ft.
 2) ft. 3) ft., or 4) Dry Well
 WELL'S STATIC WATER LEVEL: 27 ft.
 below land surface, measured on (mo-day-yr) 7/27/15
 above land surface, measured on (mo-day-yr)
 Pump test data: Well water was ft. after hours pumping gpm
 Well water was ft. after hours pumping gpm
 Estimated Yield: 20 gpm
 Bore Hole Diameter: 10.5 in. to 56 ft. and in. to ft.

5 Latitude: (decimal degrees)
Longitude: (decimal degrees)
 Datum: WGS 84 NAD 83 NAD 27
 Source for Latitude/Longitude:
 GPS (unit make/model:)
 (WAAS enabled? Yes No)
 Land Survey Topographic Map
 Online Mapper:

6 Elevation: ft. Ground Level TOC
 Source: Land Survey GPS Topographic Map
 Other

7 WELL WATER TO BE USED AS:

1. Domestic
 Household
 Lawn & Garden
 Livestock
2. Irrigation
3. Feedlot
4. Industrial

5. Public Water Supply: well ID

6. Dewatering: how many wells?

7. Aquifer Recharge: well ID

8. Monitoring: well ID

9. Environmental Remediation: well ID

Air Sparge Soil Vapor Extraction
 Recovery Injection

10. Oil Field Water Supply: lease

11. Test Hole: well ID

Cased Uncased Geotechnical

12. Geothermal: how many bores?

a) Closed Loop Horizontal Vertical
 b) Open Loop Surface Discharge Inj. of Water

13. Other (specify):

Was a chemical/bacteriological sample submitted to KDHE? Yes No If yes, date sample was submitted:

Water well disinfected? Yes No

8 TYPE OF CASING USED: Steel PVC Other CASING JOINTS: Glued Clamped Welded Threaded
 Casing diameter 5 in. to ft., Diameter in. to ft., Diameter in. to ft.
 Casing height above land surface 1.2 in. Weight lbs./ft. Wall thickness or gauge No. 1160PS2
 TYPE OF SCREEN OR PERFORATION MATERIAL:
 Steel Stainless Steel Fiberglass PVC Other (Specify)
 Brass Galvanized Steel Concrete tile None used (open hole)
 SCREEN OR PERFORATION OPENINGS ARE:
 Continuous Slot Mill Slot Gauze Wrapped Torch Cut Drilled Holes Other (Specify)
 Louvered Shutter Key Punched Wire Wrapped Saw Cut None (Open Hole)
 SCREEN-PERFORATED INTERVALS: From 93 ft. to 56 ft., From ft. to ft., From ft. to ft.
 GRAVEL PACK INTERVALS: From 24 ft. to 56 ft., From ft. to ft., From ft. to ft.

9 GROUT MATERIAL: Neat cement Cement grout Bentonite Other

Grout Intervals: From 3 ft. to 24 ft., From ft. to ft., From ft. to ft.

Nearest source of possible contamination:
 Septic Tank Lateral Lines Pit Privy Livestock Pens Insecticide Storage
 Sewer Lines Cess Pool Sewage Lagoon Fuel Storage Abandoned Water Well
 Watertight Sewer Lines Seepage Pit Feedyard Fertilizer Storage Oil Well/Gas Well
 Other (Specify)

Direction from well? South Distance from well? 18 ft.

10 FROM	TO	LITHOLOGIC LOG	FROM	TO	LITHO. LOG (cont.) or PLUGGING INTERVALS
0	1	TOP SOIL			
1	25	clay			
25	30	med. gravel			
30	37	clay			
37	53	med. gravel			
53	56	shale			
Notes:					

11 CONTRACTOR'S OR LANDOWNER'S CERTIFICATION: This water well was constructed, reconstructed, or plugged under my jurisdiction and was completed on (mo-day-year) 7-27-15 and this record is true to the best of my knowledge and belief.
 Kansas Water Well Contractor's License No. 8813 This Water Well Record was completed on (mo-day-year) 8-7-15
 under the business name of Wentinger Drilling