

State

WATER WELL RECORD Form WWC-5


Division of Water Resources App. No.

Well ID

Original Record Correction Change in Well Use

1 LOCATION OF WATER WELL: County: Sedgwick Fraction NE 1/4 NW 1/4 NW 1/4 NW 1/4 Section Number 9 Township Number T 29 S Range Number R 1 E

2 WELL OWNER: First Name: Atterbury, Last Name: Dusty, Address: 403 E. 79th St, City: Haysville, State: Ka, ZIP: 67060

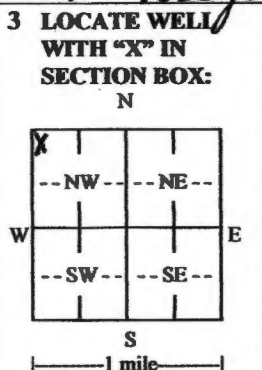

3 LOCATE WELL WITH 'X' IN SECTION BOX: 4 DEPTH OF COMPLETED WELL: 60 ft. Depth(s) Groundwater Encountered: 1) 10 ft. 2) ... 3) ... 4) Dry Well. WELL'S STATIC WATER LEVEL: 10 ft. below land surface, measured on (mo-day-yr). Pump test data: Well water was ... after ... hours pumping ... gpm. Estimated Yield: 20+ gpm. Bore Hole Diameter: 12 in. to 6.0 ft. and ... in. to ... ft.

5 Latitude: 37.549467 (decimal degrees) Longitude: 97.3321089 (decimal degrees) Datum: WGS 84 NAD 83 NAD 27 Source for Latitude/Longitude: GPS (unit make/model: ... (WAAS enabled? Yes No) Land Survey Topographic Map Online Mapper.

6 Elevation: ... ft. Ground Level TOC Source: Land Survey GPS Topographic Map Other.

7 WELL WATER TO BE USED AS: 1. Domestic: Household Lawn & Garden Livestock Irrigation Feedlot Industrial. 2. Public Water Supply: well ID. 3. Dewatering: how many wells? 4. Aquifer Recharge: well ID. 5. Monitoring: well ID. 6. Environmental Remediation: well ID. 7. Air Sparge Soil Vapor Extraction Recovery Injection. 8. Oil Field Water Supply: lease. 9. Test Hole: well ID. 10. Cased Uncased Geotechnical. 11. Geothermal: how many bores? a) Closed Loop Horizontal Vertical b) Open Loop Surface Discharge Inj. of Water. 12. Other (specify):

Was a chemical/bacteriological sample submitted to KDHE? Yes No. If yes, date sample was submitted: Water well disinfected? Yes No.

8 TYPE OF CASING USED: Steel PVC Other. CASING JOINTS: Glued Clamped Welded Threaded. Casing diameter: 5 in. to 6.0 ft., Diameter: ... in. to ... ft., Diameter: ... in. to ... ft. Casing height above land surface: 12 in. Weight: 16.0 lbs./ft. Wall thickness or gauge No.: 26.

TYPE OF SCREEN OR PERFORATION MATERIAL: Steel Stainless Steel Fiberglass PVC Other (Specify). Brass Galvanized Steel Concrete tile None used (open hole).

SCREEN OR PERFORATION OPENINGS ARE: Continuous Slot Mill Slot Gauze Wrapped Torch Cut Drilled Holes Other (Specify). Louvered Shutter Key Punched Wire Wrapped Saw Cut None (Open Hole).

SCREEN-PERFORATED INTERVALS: From 4.0 ft. to 6.0 ft., From ... ft. to ... ft., From ... ft. to ... ft. GRAVEL PACK INTERVALS: From 2.4 ft. to 6.0 ft., From ... ft. to ... ft., From ... ft. to ... ft.

9 GROUT MATERIAL: Neat cement Cement grout Bentonite Other. Grout Intervals: From 4 ft. to 2.4 ft., From ... ft. to ... ft., From ... ft. to ... ft.

Nearest source of possible contamination: Septic Tank Lateral Lines Pit Privy Livestock Pens Insecticide Storage Sewer Lines Cess Pool Sewage Lagoon Fuel Storage Abandoned Water Well Watertight Sewer Lines Seepage Pit Feedyard Fertilizer Storage Oil Well/Gas Well Other (Specify). Direction from well? West Distance from well? 200 ft.

Table with 6 columns: FROM, TO, LITHOLOGIC LOG, FROM, TO, LITHO. LOG (cont.) or PLUGGING INTERVALS. Rows show depth intervals and lithology: 0-2 Topsoil, 2-15 fine sand, 15-35 coarse sand, 35-42 med sand, 42-60 coarse sand + gravel.

11 CONTRACTOR'S OR LANDOWNER'S CERTIFICATION: This water well was constructed, reconstructed, or plugged under my jurisdiction and was completed on (mo-day-year) 9/11/15 and this record is true to the best of my knowledge and belief. Kansas Water Well Contractor's License No. 611. This Water Well Record was completed on (mo-day-year) 10-10-15 under the business name of Chan Drilling.