

WATER WELL RECORD

Form WWC-5

Division of Water Resources App. No.


Well ID

MW7D

Original Record Correction Change in Well Use

1 LOCATION OF WATER WELL: Fraction Section Number Township Number Range Number

2 WELL OWNER: Last Name: Business: Address: City: Haysville State: KS ZIP: Street or Rural Address where well is located

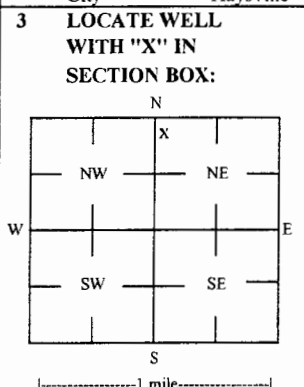

3 LOCATE WELL WITH 'X' IN SECTION BOX: 4 DEPTH OF COMPLETED WELL: 48.5 ft

5 Latitude: NA Longitude: NA Horizontal Datum: WGS 84

7 WELL WATER TO BE USED AS: 1 Domestic 2 Irrigation 3 Feedlot 4 Industrial 5 Public Water Supply 6 Dewatering 7 Aquifer Recharge 8 Monitoring 9 Environmental Remediation 10 Oil Field Water Supply 11 Test Hole 12 Geothermal

Was a chemical/bacteriological sample submitted to KDHE? Water well disinfected?

8 TYPE OF CASING USED: Steel PVC Other CASING JOINTS: Glued Clamped Welded Threaded

9 GROUT MATERIAL: Neat cement Cement grout Bentonite Other Concrete: 0-0.5'

Nearest source of possible contamination: Septic Tank Lateral Lines Pit Privy Livestock Pens Insecticide Storage

Table with columns: 10 FROM, TO, LITHOLOGIC LOG, FROM, TO, LITHO. LOG (cont.) or PLUGGING INTERVALS

KDHE ID: C2-087-72896 Target of monitoring well is shallow groundwater.

11 CONTRACTOR'S OR LANDOWNER'S CERTIFICATION: This water well was constructed, reconstructed, or plugged

Sedgwick Co T.29 R.1E Sec 5, 8, 9

Former American Cleaners Site - MW-6 through MW-14 Locations

