

WATER WELL PLUGGING RECORD Form WWC-5P

KSA 82a-1212

ID NO.

MW-15

1 LOCATION OF WATER WELL: County: Sedgwick	Fraction SE ¼ SE ¼ SE ¼ NW ¼	Section Number 12	Township Number T 29 S	Range Number 1 ☒ E ☐ W
--	---------------------------------	----------------------	---------------------------	--

Street/Rural Address of Well Location; if unknown, distance & direction from nearest town or intersection: If at owner's address, check here ☐ Approximately 35 Feet Northeast of the Intersection of W Kay St. & S Buckner St. Derby, Kansas 67037


Global Positioning Systems (GPS) information:

Latitude: 37.5413231 (in decimal degrees)
Longitude: 97.2712709 (in decimal degrees)
Elevation: TOC: 1272.99
Horizontal Datum: ☐ WGS84, ☒ NAD83, ☐ NAD27
Collection Method:

2 WATER WELL OWNER: Phillips 66
RR#, St. Address, Box #: 420 S Keeler, 1708-03 Phillips
City, State ZIP Code: Bartlesville, OK 74003

☐ GPS unit (Make/Model: _____)
☒ Digital Map/Photo, ☐ Topographic Map, ☐ Land Survey
Est. Accuracy: ☐ < 3 m, ☒ 3-5 m, ☐ 5-15 m, ☐ > 15 m

3 MARK WELL'S LOCATION WITH AN "X" IN SECTION BOX:

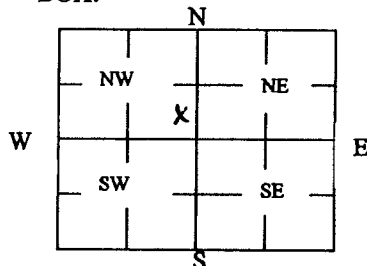

4 DEPTH OF WELL 44.0 ft.

WELL'S STATIC WATER LEVEL 34.01 ft

WELL WAS USED AS:

- | | | |
|-------------------------------------|---|--|
| ☐ Domestic | ☐ Public Water Supply | ☐ Dewatering |
| ☐ Irrigation | ☐ Oil Field Water Supply | ☒ Monitoring |
| ☐ Feedlot | ☐ Domestic (Lawn & Garden) | ☐ Injection Well |
| ☐ Industrial | ☐ Air Conditioning | ☐ Other _____ |

Was a chemical/bacteriological sample submitted to Department? Yes ☐ No ☒

5 TYPE OF BLANK CASING USED:

- ☐ Steel ☐ RMP (SR) ☐ Wrought ☐ Fiberglass ☐ Other (Specify below)
☒ PVC ☐ ABS ☐ Asbestos-Cement ☐ Concrete Tile

Blank casing diameter _____ in. Was casing pulled? Yes ☒ No ☐ If yes, how much Top 10 Feet
Casing height above or below land surface _____ in.

6 GROUT PLUG MATERIAL: ☒ Neat cement ☐ Cement grout ☒ Bentonite ☐ Other _____

Grout Plug Intervals: From 0 ft. to 44 ft., From _____ ft. to _____ ft., From _____ ft. to _____ ft.

What is the nearest source of possible contamination:

- | | | | |
|---|---|---|--|
| ☐ Septic tank | ☐ Seepage pit | ☐ Fuel storage | ☐ Other (specify below) _____ |
| ☐ Sewer lines | ☐ Pit privy | ☐ Fertilizer storage | |
| ☐ Watertight sewer lines | ☐ Sewage lagoon | ☐ Insecticide storage | |
| ☐ Lateral lines | ☐ Feedyard | ☐ Abandoned water well | |
| ☐ Cess pool | ☐ Livestock pens | ☐ Oil well/Gas well | |
- Direction from well? _____
How many feet? _____

FROM	TO	PLUGGING MATERIALS	FROM	TO	PLUGGING MATERIALS
0	10	Concrete			
10	44	Bentonite			
		Plugged at the request of			
		the Storage Tank Section			

7 CONTRACTOR'S OR LANDOWNER'S CERTIFICATION: This water well was plugged under my jurisdiction and was completed on (mo/day/year) 04.16.2019 and this record is true to the best of my knowledge and belief. Kansas Water Well Contractor's License No. _____. This Water Well Record was completed on (mo/day/year) 04.18.2019 under the business name of ATC Group Services LLC by (signature) [Signature]

Send one white copy to Kansas Department of Health & Environment, Geology Section, 1000 SW Jackson Street, Ste. 420, Topeka, KS 66612-1367. Send one copy to WATER WELL OWNER and retain one for your records.
Visit us at <http://www.kdheks.gov/waterwell/index.html> Telephone 785-296-5524.

KSA82a-1212

Revised 1/20/2015