WATER WELL RECORD Form WWC-5 KSA 82a-1212

1 LOCATION OF WATER WELL: County: SEDGWICK

Fraction: SW ¼ SE ¼ SE ¼ NE ¼ | Section Number: 17 | Township Number: T 29 S | Range Number: R 1 E/W EAST

Distance and direction from nearest town or city street address of well if located within city?
9182 York Ct. Wichita, Kansas

2 WATER WELL OWNER: A. J. Schelgal Built Homes
RR#, St. Address, Box # : 917 East 103rd St. So.
City, State, ZIP Code : Wichita, Kansas

SPEC. HOUSE
Board of Agriculture, Division of Water Resources
Application Number:

3 LOCATE WELL'S LOCATION WITH AN "X" IN SECTION BOX:

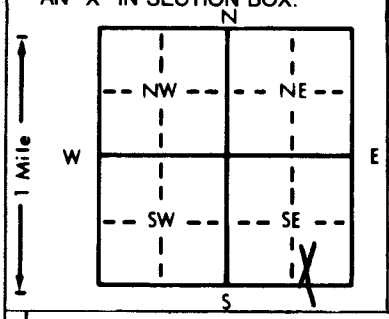

4 DEPTH OF COMPLETED WELL 40 ft. ELEVATION:
Depth(s) Groundwater Encountered 1. 15 ft. 2. ft. 3. ft.
WELL'S STATIC WATER LEVEL 15 ft. below land surface measured on mo/day/yr 10-2-84
Pump test data: Well water was ft. after hours pumping gpm
Est. Yield gpm: Well water was ft. after hours pumping gpm
Bore Hole Diameter 11 in. to ft., and in. to ft.
WELL WATER TO BE USED AS: 1 Domestic; ~~2 Irrigation~~; 3 Feedlot; 4 Industrial; 5 Public water supply; 6 Oil field water supply; 7 Lawn and garden only; 8 Air conditioning; 9 Dewatering; 10 Observation well; 11 Injection well; 12 Other (Specify below)
Was a chemical/bacteriological sample submitted to Department? Yes ..... No XX; If yes, mo/day/yr sample was submitted
Water Well Disinfected? Yes XX No

5 TYPE OF BLANK CASING USED: 1 Steel; 2 PVC; 3 RMP (SR); 4 ABS; 5 Wrought iron; 6 Asbestos-Cement; 7 Fiberglass; 8 Concrete tile; 9 Other (specify below) Cer-Mac styrene SDR-26
CASING JOINTS: Glued XX Clamped; Welded; Threaded
Blank casing diameter 5 in. to 20 ft., Dia in. to ft., Dia in. to ft.
Casing height above land surface 12 in., weight 1.59 lbs./ft. Wall thickness or gauge No. .203
TYPE OF SCREEN OR PERFORATION MATERIAL: 1 Steel; 2 Brass; 3 Stainless steel; 4 Galvanized steel; 5 Fiberglass; 6 Concrete tile; 7 PVC; 8 RMP (SR); 9 ABS; 10 Asbestos-cement; 11 Other (specify); 12 None used (open hole)
SCREEN OR PERFORATION OPENINGS ARE: 1 Continuous slot; 2 Louvered shutter; 3 Mill slot; 4 Key punched; 5 Gauzed wrapped; 6 Wire wrapped; 7 Torch cut; 8 Saw cut; 9 Drilled holes; 10 Other (specify); 11 None (open hole)
SCREEN-PERFORATED INTERVALS: From 20 ft. to 40 ft., From ft. to ft.
From ft. to ft., From ft. to ft.
GRAVEL PACK INTERVALS: From 14 ft. to 40 ft., From ft. to ft.
From ft. to ft., From ft. to ft.

6 GROUT MATERIAL: 1 Neat cement; 2 Cement grout; 3 Bentonite; 4 Other
Grout Intervals: From 4 ft. to 14 ft., From ft. to ft., From ft. to ft.
What is the nearest source of possible contamination: 1 Septic tank; 2 Sewer lines; 3 Watertight sewer lines; 4 Lateral lines; 5 Cess pool; 6 Seepage pit; 7 Pit privy; 8 Sewage lagoon; 9 Feedyard; 10 Livestock pens; 11 Fuel storage; 12 Fertilizer storage; 13 Insecticide storage; 14 Abandoned water well; 15 Oil well/Gas well; 16 Other (specify below)
Direction from well? East How many feet? 54

FROM	TO	LITHOLOGIC LOG	FROM	TO	LITHOLOGIC LOG
0	3	Topsoil			
3	8	Clay			
8	18	Fine Sand			
18	40	Medium Sand			

7 CONTRACTOR'S OR LANDOWNER'S CERTIFICATION: This water well was (1) constructed, (2) reconstructed, or (3) plugged under my jurisdiction and was completed on (mo/day/year) 10-2-84 and this record is true to the best of my knowledge and belief. Kansas Water Well Contractor's License No. 236 This Water Well Record was completed on (mo/day/yr) 4-15-85
under the business name of Harp Well & Pump Service, Inc. by (signature) Mary Arnold

INSTRUCTIONS: Use typewriter or ball point pen, *PLEASE PRESS FIRMLY* and *PRINT* clearly. Please fill in blanks, underline or circle the correct answers. Send top three copies to Kansas Department of Health and Environment, Division of Environment, Environmental Geology Section, Topeka, KS 66620. Send one to WATER WELL OWNER and retain one for your records.

OFFICE USE ONLY T R E/W SEC. ¼ ¼ ¼