USE TYPEWRITER OR BALL POINT PEN-PRESS FIRMLY, PRINT CLEARLY.

WATER WELL RECORD
KSA 82a-1201-1215

Kansas Department of Health and Environment-Division of Environment
(Water well Contractors)
Topeka, Kansas 66620

1. Location of well:	County: Sedgwick	Fraction: NW 1/4 NE 1/4 SE 1/4	Section number: 1	Township number: T 29 S	Range number: R 1 (E) W

2. Distance and direction from nearest town or city:
Street address of well location if in city: 6698 S.E Blvd. Wichita, Kans.

3. Owner of well: Arnold Mix
R.R. or street: 212 East Madison
City, state, zip code: Derby, Kansas

4. Locate with "X" in section below:

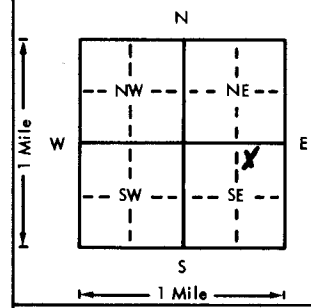

Sketch map:

6. Bore hole dia. 7 1/2 in. Completion date 10-6-75
Well depth 75 ft.

7. __ Cable tool X Rotary __ Driven __ Dug
__ Hollow rod __ Jetted __ Bored __ Reverse rotary

8. Use: X Domestic __ Public supply __ Industry
__ Irrigation __ Air conditioning __ Stock
__ Lawn __ Oil field water __ Other

9. Casing: Material: Styrene Height: Above or below
Threaded __ Welded __ Surface 12 in.
RMP X PVC __ Weight __ lbs./ft.
Dia. 5 in. to 75 ft. depth Wall Thickness: inches or
Dia. __ in. to __ ft. depth gage No. .200

10. Screen: Manufacturer's name Sunflower Plastic
Type Styrene Dia. 5"
Slot/gauze .050 Length 28'
Set between 47 ft. and 75 ft.
ft. and ft.
Gravel pack? yes Size range of material 1/4-1/8"

5. Type and color of material	From	To
Dirt	0	3
Clay	3	42
Fine Sand	42	52
Shale	52	75

(Use a second sheet if needed)

11. Static water level: mo./day/yr.
20 ft. below land surface Date 10-6-75

12. Pumping level below land surfaces:
__ ft. after __ hrs. pumping __ g.p.m.
__ ft. after __ hrs. pumping __ g.p.m.
Estimated maximum yield __ g.p.m.

13. Water sample submitted: mo./day/yr.
__ Yes __ No Date

14. Well head completion: capped
__ Pitless adapter 12 inches above grade

15. Well grouted? yes
With: __ Neat cement __ Bentonite X Concrete
Depth: From 40" to 14 ft.

16. Nearest source of possible contamination: Septic
ft. 60 Direction East Type Tank
Well disinfected upon completion? X Yes __ No

17. Pump: X Not installed
Manufacturer's name
Model number HP Volts
Length of drop pipe ft. capacity g.p.m.
Type:
__ Submersible __ Turbine
__ Jet __ Reciprocating
__ Centrifugal __ Other

18. Elevation:
Topography:
__ Hill
__ Slope
__ Upland
__ Valley

19. Remarks: Flat Ground

20. Water well contractor's certification:
This well was drilled under my jurisdiction and this report is true to the best of my knowledge and belief.
Business name Harp Well & Pump License No. 236
Address Wichita, Kans.
Signed M. Arnold Date 10-8-75
Authorized representative

T 29 R 1 (E) W Sec 1 NW 1/4 NE 1/4 SE 1/4

Forward the white, blue and pink copies to the Department of Health and Environment

Form WWC-5

M1-1023