


1 LOCATION OF WATER WELL: Fraction NW 1/4 NE 1/4 NW 1/4 Section Number 1 Township Number T 29 S Range Number R 1 E E/W

Distance and direction from nearest town or city street address of well if located within city? 5329 E. 71st St. So. Derby, Ks.

2 WATER WELL OWNER: Ellsworth Tibbetts RR#, St. Address, Box #: 5329 E. 71st St. So. Board of Agriculture, Division of Water Resources City, State, ZIP Code: Derby, Kansas Application Number:

3 LOCATE WELL'S LOCATION WITH AN "X" IN SECTION BOX:

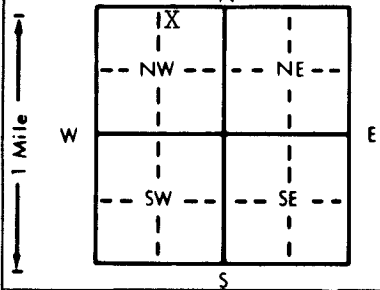

4 DEPTH OF COMPLETED WELL: 80 ft. ELEVATION: ... WELL'S STATIC WATER LEVEL: 43 ft. below land surface measured on mo/day/yr 7-1-83. Pump test data: Well water was ... Est. Yield ... Bore Hole Diameter: .11 in. to ... WELL WATER TO BE USED AS: 5 Public water supply, 8 Air conditioning, 11 Injection well, 1 Domestic, 3 Feedlot, 6 Oil field water supply, 9 Dewatering, 12 Other (Specify below), 2 Irrigation, 4 Industrial, 7 Lawn and garden only, 10 Observation well. Was a chemical/bacteriological sample submitted to Department? Yes... No... X...; If yes, mo/day/yr sample was submitted. Water Well Disinfected? Yes X No

5 TYPE OF BLANK CASING USED: 1 Steel, 3 RMP (SR), 2 PVC, 4 ABS, 5 Wrought iron, 6 Asbestos-Cement, 7 Fiberglass, 8 Concrete tile, 9 Other (specify below) Cer-Mac styrene SDR-26, CASING JOINTS: Glued X Clamped, Welded, Threaded.

Blank casing diameter: 5 in. to 45 ft., Dia. Casing height above land surface: 12 in., weight: 1.59 lbs./ft. Wall thickness or gauge No. 203.

TYPE OF SCREEN OR PERFORATION MATERIAL: 1 Steel, 3 Stainless steel, 5 Fiberglass, 7 PVC, 8 RMP (SR), 10 Asbestos-cement, 2 Brass, 4 Galvanized steel, 6 Concrete tile, 9 ABS, 11 Other (specify), 12 None used (open hole).

SCREEN OR PERFORATION OPENINGS ARE: 1 Continuous slot, 3 Mill slot, 5 Gauzed wrapped, 6 Wire wrapped, 7 Torch cut, 8 Saw cut, 9 Drilled holes, 11 None (open hole), 2 Louvered shutter, 4 Key punched, 7 Other (specify).

SCREEN-PERFORATED INTERVALS: From 45 ft. to 80 ft. GRAVEL PACK INTERVALS: From 14 ft. to 80 ft.

6 GROUT MATERIAL: 1 Neat cement, 2 Cement grout, 3 Bentonite, 4 Other. Grout Intervals: From 4 ft. to 14 ft.

What is the nearest source of possible contamination: 1 Septic tank, 4 Lateral lines, 7 Pit privy, 10 Livestock pens, 14 Abandoned water well, 2 Sewer lines, 5 Cess pool, 8 Sewage lagoon, 11 Fuel storage, 15 Oil well/Gas well, 3 Watertight sewer lines, 6 Seepage pit, 9 Feedyard, 12 Fertilizer storage, 16 Other (specify below), 13 Insecticide storage.

Direction from well? Southwest How many feet? 58

LITHOLOGIC LOG table with columns FROM, TO, LITHOLOGIC LOG, FROM, TO, LITHOLOGIC LOG. Data: 0-3 Topsoil, 3-31 Clay, 31-48 Fine Sand, 48-57 Medium Sand, 57-80 Grey Shale.

7 CONTRACTOR'S OR LANDOWNER'S CERTIFICATION: This water well was (1) constructed, (2) reconstructed, or (3) plugged under my jurisdiction and was completed on (mo/day/year) 7-1-83 and this record is true to the best of my knowledge and belief. Kansas Water Well Contractor's License No. 236 This Water Well Record was completed on (mo/day/yr) 10-28-23 under the business name of Harp Well & Pump Service, Inc. by (signature) Mary Arnold

INSTRUCTIONS: Use typewriter or ball point pen, PLEASE PRESS FIRMLY and PRINT clearly. Please fill in blanks, underline or circle the correct answers. Send top three copies to Kansas Department of Health and Environment, Division of Environment, Environmental Geology Section, Topeka, KS 66620. Send one to WATER WELL OWNER and retain one for your records.

OFFICE USE ONLY T 29 R 1 SEC. 1 NW 1/4 NE 1/4 SW 1/4