


USE TYPEWRITER OR BALL
POINT PEN-PRESS FIRMLY,
PRINT CLEARLY.

WATER WELL RECORD
KSA 82a-1201-1215

Kansas Department of Health and
Environment-Division of Environment
(Water well Contractors)
Topeka, Kansas 66620

1. Location of well:	County	Sedgwick	Fraction	1/4 SW 1/4 SW 1/4	Section number	4	Township number	29	Range number	1E	E/W
----------------------	--------	----------	----------	-------------------	----------------	---	-----------------	----	--------------	----	-----

2. Distance and direction from nearest town or city:	618 East 79th So.	City, state, zip code:	Wichita, Kansas
3. Owner of well:	Orville White	R.R. or street:	618 East 79th So.
4. Locate with "X" in section below:	Sketch map:		

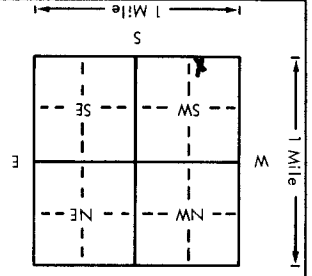

4. Locate with "X" in section below:	Sketch map:					
5. Type and color of material	From To					
Sandy Topsoil	0 3					
Brown Clay	3 9					
Brown Clay mixed with fine sand	9 14					
Fine Sand	14 20					
Coarse Sand	20 40					
12. Pumping level below land surfaces:	ft. after hrs. pumping	g.p.m.				
13. Water sample submitted:	Yes	No	Date			
14. Well head completion:	12	capped				
15. Well grouted?	yes	1-2 fine sand mix				
16. Nearest source of possible contamination:	100	South Tank				
17. Pump:	Model number	HP	Volts	Length of drop pipe	ft. capacity	g.p.m.
18. Elevation:	Topography: Hill Slope Upland Valley					

18. Elevation:	Topography: Hill Slope Upland Valley					
19. Remarks:	Flat Ground					
20. Water well contractor's certification:	This well was drilled under my jurisdiction and this report is true to the best of my knowledge and belief.					
