

E 15 24 + 22


1 LOCATION OF WATER WELL: County: SEDGWICK 173	Fraction NW 1/4 NW 1/4 NW 1/4	Section Number 5	Township Number T 29 S	Range Number R 1 EW
--	---	----------------------------	----------------------------------	-------------------------------

Distance and direction from nearest town or city street address of well if located within city?

ON RR ROW

2 WATER WELL OWNER: RR#, St. Address, Box # : City, State, ZIP Code	WALTERS-MORGAN INC PO Box 1687 MANHATTAN KS 66502	Board of Agriculture, Division of Water Resources Application Number:
---	--	--

3 LOCATE WELL'S LOCATION WITH AN "X" IN SECTION BOX:

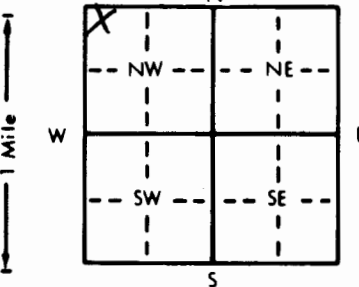

4 DEPTH OF COMPLETED WELL: 30 ft.	ELEVATION:
Depth(s) Groundwater Encountered 1. ft. 2. ft. 3. ft.	
WELL'S STATIC WATER LEVEL 16 ft. below land surface measured on mo/day/yr 5-21-84	
Pump test data: Well water was ft. after hours pumping gpm	
Est. Yield gpm: Well water was ft. after hours pumping gpm	
Bore Hole Diameter 26 in. to 30 ft., and in. to ft.	
WELL WATER TO BE USED AS:	
1 Domestic WAS 3 Feedlot 6 Oil field water supply 9 Dewatering 12 Other (Specify below)	5 Public water supply 8 Air conditioning 11 Injection well
2 Irrigation 4 Industrial 7 Lawn and garden only 10 Observation well	
Was a chemical/bacteriological sample submitted to Department? Yes.....No.....; If yes, mo/day/yr sample was submitted	Water Well Disinfected? Yes No

5 TYPE OF BLANK CASING USED:	5 Wrought iron	8 Concrete tile	CASING JOINTS: Glued Clamped
<u>1 Steel</u> 3 RMP (SR)	6 Asbestos-Cement	9 Other (specify below)	Welded
2 PVC 4 ABS	7 Fiberglass		Threaded
Blank casing diameter 12 in. to 18 ft., Dia in. to ft., Dia in. to ft.			
Casing height above land surface in., weight lbs./ft. Wall thickness or gauge No.			
TYPE OF SCREEN OR PERFORATION MATERIAL:	7 PVC	10 Asbestos-cement	
<u>1 Steel</u> 3 Stainless steel 5 Fiberglass 8 RMP (SR) 11 Other (specify)			
2 Brass 4 Galvanized steel 6 Concrete tile 9 ABS 12 None used (open hole)			
SCREEN OR PERFORATION OPENINGS ARE:	5 Gauzed wrapped	8 Saw cut	11 None (open hole)
1 Continuous slot 3 Mill slot 6 Wire wrapped 9 Drilled holes			
2 Louvered shutter 4 Key punched 7 Torch cut 10 Other (specify)			
SCREEN-PERFORATED INTERVALS: From 18 ft. to 30 ft., From ft. to ft.			
GRAVEL PACK INTERVALS: From ft. to ft., From ft. to ft.			

6 GROUT MATERIAL:	1 Neat cement	2 Cement grout	3 Bentonite	4 Other
Grout Intervals: From ft. to ft., From ft. to ft., From ft. to ft.				
What is the nearest source of possible contamination:	1 Septic tank	4 Lateral lines	7 Pit privy	10 Livestock pens
	2 Sewer lines	5 Cess pool	8 Sewage lagoon	11 Fuel storage
	3 Watertight sewer lines	6 Seepage pit	9 Feedyard	12 Fertilizer storage
				13 Insecticide storage
				14 Abandoned water well
				15 Oil well/Gas well
				16 Other (specify below)

FROM	TO	LITHOLOGIC LOG	FROM	TO	LITHOLOGIC LOG
30	0	05 SAND NATIVE			
		Due to Soil and Weather Conditions Wells caved in and were topped off with native topsoil & compacted.			
		City of Haysville, KS			
		EPA Project No. C200685			

7 CONTRACTOR'S OR LANDOWNER'S CERTIFICATION: This water well was (1) constructed, (2) reconstructed, or (3) plugged under my jurisdiction and was completed on (mo/day/year) 5-21-84 and this record is true to the best of my knowledge and belief. Kansas Water Well Contractor's License No. This Water Well Record was completed on (mo/day/yr) 5-21-84 under the business name of by (signature) <i>[Signature]</i>

INSTRUCTIONS: Use typewriter or ball point pen, PLEASE PRESS FIRMLY and PRINT clearly. Please fill in blanks, underline or circle the correct answers. Send top three copies to Kansas Department of Health and Environment, Division of Environment, Environmental Geology Section, Topeka, KS 66620. Send one to WATER WELL OWNER and retain one for your records.

[Handwritten mark]