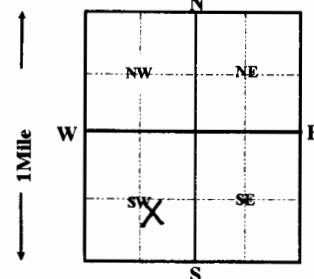


1 LOCATION OF WATER WELL: Sedgwick		FRACTION NW 1/4 SE 1/4 SW 1/4		Section Number 5	Township Number T 29 S		Range Number R 1E E/W	
Distance and direction from nearest town or city street address of well if located within city? 7840 Shady Creek Haysville, Kansas								
2 WATER WELL OWNER: WARREN, Carl RR#, ST. ADDRESS, BOX #: 7840 Shady Creek CITY, STATE, ZIP CODE: Haysville, Kansas Board of Agriculture, Division of Water Resource Application Number:								
3 LOCATE WELL'S LOCATION WITH AN "X" IN SECTION BOX: 			4 DEPTH OF COMPLETED WELL 50 ft. ELEVATION: Depth(s) groundwater Encountered 1 ft. 2 ft. 3 ft. WELL'S STATIC WATER LEVEL 16 FT. BELOW LAND SURFACE MEASURED ON 09/04/1992 Pump test data: Well water was ft. after hours pumping gpm Est. Yield gpm Well water was ft. after hours pumping gpm Bore Hole Diameter 12 in. to 50 ft., and in. to ft. WELL WATER TO BE USED AS: 5 Public water supply 8 Air conditioning 11 Injection well 1 Domestic 3 Feedlot 6 Oil field water supply 9 Dewatering 12 Other (Specify below) 2 Irrigation 4 Industrial 7 Lawn and garden only 10 Monitoring well Was a chemical/bacteriological sample submitted to Department? Yes No X ; If yes, mo/day/yr sample was submitted Water Well Disinfected? Yes X No					
5 TYPE OF CASING USED: 1 Steel 3 RMP (SR) 5 Wrought iron 8 Concrete tile CASING JOINTS: Glued X Clamped 2 PVC 4 ABS 6 Asbestos-Cement 9 Other (Specify below) Welded Blank casing Diameter 5 in. to 40 ft., Dia in. to ft., Dia in. to ft. SDR-26 Threaded Casing height above land surface 16 in., weight 2.35 lbs. / ft. Wall thickness or gauge No. .214 TYPE OF SCREEN OR PERFORATION MATERIAL: 1 Steel 3 Stainless Steel 5 Fiberglass 8 RMP (SR) 11 other (specify) 2 Brass 4 Galvanized steel 6 Concrete tile 9 ABS 12 None used (open hole) SCREEN OR PERFORATION OPENING ARE: 1 Continuous slot 3 Mill slot 5 Gauzed wrapped 8 Saw cut 11 None (open hole) 2 Louvered shutter 4 Key punched 6 Wire wrapped 9 Drilled holes 7 Torch cut 10 Other (specify) SCREEN-PERFORATION INTERVALS: from 40 ft. to 50 ft., From ft. to ft. GRAVEL PACK INTERVALS: from 24 ft. to 50 ft., From ft. to ft. from ft. to ft.								
6 GROUT MATERIAL: 1 Neat cement 2 Cement grout 3 Bentonite 4 Other Grout Intervals: From 4 ft. to 24 ft., From ft. to ft., From ft. to ft. What is the nearest source of possible contamination: 1 Septic tank 4 Lateral lines 7 Pit privy 10 Livestock pens 14 Abandon water well 2 Sewer lines 5 Cess pool 8 Sewage lagoon 11 Fuel storage 15 Oil well/Gas well 3 Watertight sewer lines 6 Seepage pit 9 Feedyard 12 Fertilizer storage 16 Other (specify below) 13 Insecticide storage Direction from well? South How many feet? 75								
FROM TO LITHOLOGIC LOG FROM TO PLUGGING INTERVALS 0 3 topsoil 3 8 clay 8 50 medium to coarse sand (dark in color)								
7 CONTRACTOR'S OR LANDOWNER'S CERTIFICATION: This water well was (1) constructed, (2) reconstructed, or (3) plugged under my jurisdiction and was completed on (mo/day/year) 09/04/1992 and this record is true to the best of my knowledge and belief. Kansas Water Well Contractor's License No. 236 This Water Well Record was completed on (mo/day/yr) 10/13/92 Under the business name of Harp Well & Pump Service, Inc. by (signature) <i>Jane Frederick</i>								