

OFFICE USE ONLY

1

五

⑤

SEC

100

4

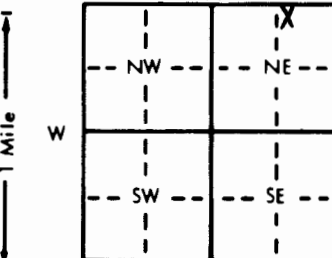
5/4

15

A

 $\frac{1}{4}$

1

1 LOCATION OF WATER WELL: County: SEDGWICK		Fraction NW 1/4 NE 1/4 NE 1/4		Section Number 8	Township Number T 29 S	Range Number R 1 E E/W
Distance and direction from nearest town or city street address of well if located within city? 101 W. 79th St. S., Haysville, Ks.						
2 WATER WELL OWNER: RR#, St. Address, Box # : City, State, ZIP Code :		David Coffey 338 W. 4th St. Haysville, Ks. Board of Agriculture, Division of Water Resources Application Number:				
3 LOCATE WELL'S LOCATION WITH AN "X" IN SECTION BOX:		4 DEPTH OF COMPLETED WELL: 40 ft. ELEVATION:				
		Depth(s) Groundwater Encountered 1. 17 ft. 2. ft. 3. ft.				
		WELL'S STATIC WATER LEVEL 17 ft. below land surface measured on mo/day/yr 7-3-82				
		Pump test data: Well water was ft. after hours pumping gpm				
		Est. Yield gpm: Well water was ft. after hours pumping gpm				
		Bore Hole Diameter 11 in. to ft., and in. to ft.				
		WELL WATER TO BE USED AS: 5 Public water supply 8 Air conditioning 11 Injection well				
		1 Domestic 3 Feedlot 6 Oil field water supply 9 Dewatering 12 Other (Specify below)				
		2 Irrigation 4 Industrial 7 Lawn and garden only 10 Observation well				
		Was a chemical/bacteriological sample submitted to Department? Yes No X; If yes, mo/day/yr sample was submitted				
5 TYPE OF BLANK CASING USED:		Water Well Disinfected? Yes X No				
1 Steel 3 RMP (SR)		5 Wrought iron 8 Concrete tile CASING JOINTS: Glued X Clamped				
2 PVC 4 ABS		6 Asbestos-Cement 9 Other (specify below) Welded				
		7 Fiberglass Threaded				
Blank casing diameter 5 in. to 25 ft. Dia		Cer-Mac Styrene SDR-26				
Casing height above land surface 12 in., weight 1.59 lbs./ft.		Wall thickness or gauge No. 203				
TYPE OF SCREEN OR PERFORATION MATERIAL:		7 PVC 10 Asbestos-cement				
1 Steel 3 Stainless steel 5 Fiberglass 8 RMP (SR) 11 Other (specify)		2 Brass 4 Galvanized steel 6 Concrete tile 9 ABS 12 None used (open hole)				
SCREEN OR PERFORATION OPENINGS ARE:		8 Saw cut 11 None (open hole)				
1 Continuous slot 3 Mill slot 5 Gauzed wrapped 8 Wire wrapped 9 Drilled holes		2 Louvered shutter 4 Key punched 7 Torch cut 10 Other (specify)				
SCREEN-PERFORATED INTERVALS: From 25 ft. to 40 ft.		From ft. to ft.				
GRAVEL PACK INTERVALS: From 14 ft. to 40 ft.		From ft. to ft.				
6 GROUT MATERIAL: 1 Neat cement 2 Cement grout 3 Bentonite 4 Other		Grout Intervals: From 4 ft. to 14 ft. From ft. to ft.				
What is the nearest source of possible contamination:		10 Livestock pens 14 Abandoned water well				
1 Septic tank 4 Lateral lines 7 Pit privy 11 Fuel storage 15 Oil well/Gas well		2 Sewer lines 5 Cess pool 8 Sewage lagoon 12 Fertilizer storage 16 Other (specify below)				
3 Watertight sewer lines 6 Seepage pit 9 Feedyard 13 Insecticide storage		NONE APPARENT				
Direction from well?		How many feet?				
FROM	TO	LITHOLOGIC LOG	FROM	TO	LITHOLOGIC LOG	
0	3	Topsoil				
3	11	Clay				
11	27	Fine Sand				
27	40	Medium Sand				
7 CONTRACTOR'S OR LANDOWNER'S CERTIFICATION: This water well was (1) constructed, (2) reconstructed, or (3) plugged under my jurisdiction and was completed on (mo/day/year) 7-3-82 and this record is true to the best of my knowledge and belief. Kansas Water Well Contractor's License No. 236 This Water Well Record was completed on (mo/day/yr) 10-4-82 under the business name of Harp Well & Pump Serv., Inc. by (signature) M. Arnold						
INSTRUCTIONS: Use typewriter or ball point pen, PLEASE PRESS FIRMLY and PRINT clearly. Please fill in blanks, underline or circle the correct answers. Send top three copies to Kansas Department of Health and Environment, Division of Environment, Environmental Geology Section, Topeka, KS 66620. Send one to WATER WELL OWNER and retain one for your records.						