


1 LOCATION OF WATER WELL: County: SEDGWICK Fraction: NW 1/4 SE 1/4 SE 1/4 Section Number: 9 Township Number: T 29 S Range Number: R 1 E

Distance and direction from nearest town or city street address of well if located within city?
1417 E 85th S. Wick KS 67233

2 WATER WELL OWNER: INTERITY HOMES
 RR#, St. Address, Box #: 442 Lexington Board of Agriculture, Division of Water Resources
 City, State, ZIP Code: Wick KS 67214 Application Number:

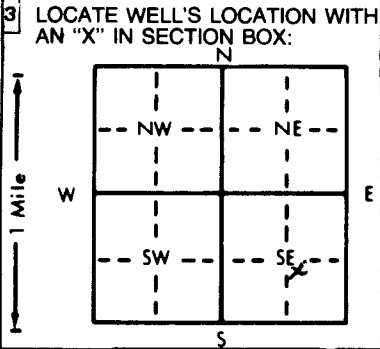

4 DEPTH OF COMPLETED WELL: 26 ft. ELEVATION: 1150
 Depth(s) Groundwater Encountered: 8 ft. 1. 8 ft. 2. 8 ft. 3. 8 ft.
 WELL'S STATIC WATER LEVEL: 8 ft. below land surface measured on mo/day/yr
 Pump test data: Well water was 10 ft. after 1 hr hours pumping 12 gpm
 Est. Yield: 20+ gpm; Well water was 10 ft. after 1 hr hours pumping 12 gpm
 Bore Hole Diameter: 9 in. to 26 ft., and 26 in. to 26 ft.
 WELL WATER TO BE USED AS:
 Domestic 3 Feedlot 6 Oil field water supply 9 Dewatering 12 Other (Specify below)
 2 Irrigation 4 Industrial 7 Lawn and garden only 10 Monitoring well
 Was a chemical/bacteriological sample submitted to Department? Yes ✓ No ✓; If yes, mo/day/yr sample was submitted
 Water Well Disinfected? Yes ✓ No ✓

5 TYPE OF CASING USED:
 1 Steel 3 RMP (SR) 5 Wrought iron 8 Concrete tile CASING JOINTS: Glued ✓ Clamped
 2 PVC 4 ABS 6 Asbestos-Cement 9 Other (specify below) Welded
 7 Fiberglass Threaded
 Blank casing diameter: 5 in. to 21 ft., Dia. 5 in. to 21 ft., Dia. 5 in. to 21 ft.
 Casing height above land surface: 12 in., weight 2.3 lbs./ft. Wall thickness or gauge No. SDR 26
 TYPE OF SCREEN OR PERFORATION MATERIAL:
 1 Steel 3 Stainless steel 5 Fiberglass 8 RMP (SR) 10 Asbestos-cement
 2 Brass 4 Galvanized steel 6 Concrete tile 9 ABS 11 Other (specify)
 12 None used (open hole)
 SCREEN OR PERFORATION OPENINGS ARE:
 1 Continuous slot 3 Mill slot 5 Gauzed wrapped 8 Saw cut 11 None (open hole)
 2 Louvered shutter 4 Key punched 6 Wire wrapped 9 Drilled holes
 7 Torch cut 10 Other (specify)
 SCREEN-PERFORATED INTERVALS: From 21 ft. to 26 ft., From 21 ft. to 26 ft., From 21 ft. to 26 ft.
 GRAVEL PACK INTERVALS: From 10 ft. to 26 ft., From 10 ft. to 26 ft., From 10 ft. to 26 ft.

6 GROUT MATERIAL: 1 Neat cement 2 Cement grout 3 Bentonite 4 Other
 Grout Intervals: From 2 ft. to 10 ft., From 2 ft. to 10 ft., From 2 ft. to 10 ft., From 2 ft. to 10 ft.
 What is the nearest source of possible contamination: NONE
 1 Septic tank 4 Lateral lines 7 Pit privy 10 Livestock pens 14 Abandoned water well
 2 Sewer lines 5 Cess pool 8 Sewage lagoon 11 Fuel storage 15 Oil well/Gas well
 3 Watertight sewer lines 6 Seepage pit 9 Feedyard 12 Fertilizer storage 16 Other (specify below)
 13 Insecticide storage
 Direction from well? How many feet?

FROM	TO	LITHOLOGIC LOG	FROM	TO	PLUGGING INTERVALS
0	3	topsoil			
3	14	FINE SAND			
14	20	med			
20	26	MED to coarse sand			

7 CONTRACTOR'S OR LANDOWNER'S CERTIFICATION: This water well was (1) constructed, (2) reconstructed, or (3) plugged under my jurisdiction and was completed on (mo/day/year) 7-18-89 and this record is true to the best of my knowledge and belief. Kansas Water Well Contractor's License No. 463 This Water Well Record was completed on (mo/day/yr) 7-24-89 under the business name of REA by (signature) Dave Reub...

6910000058-50