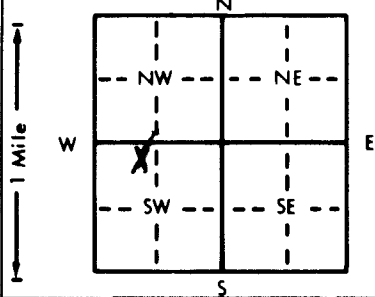


1 LOCATION OF WATER WELL: County: Sedgwick		Fraction NE 1/4 NW 1/4 SW 1/4		Section Number 9		Township Number T 29 S		Range Number R 1E E/W			
Distance and direction from nearest town or city street address of well if located within city? Lot #5 Block 1 Stillwater (approx. 8400 S. Broadway) Haysville, Ks.											
2 WATER WELL OWNER: JBL RR#, St. Address, Box #: 946 N. Broadway City, State, ZIP Code: Wichita, Ks. Board of Agriculture, Division of Water Resources Application Number:											
3 LOCATE WELL'S LOCATION WITH AN "X" IN SECTION BOX:			4 DEPTH OF COMPLETED WELL: 27 ft. ELEVATION: 12 ft. Depth(s) Groundwater Encountered 1. 12 ft. 2. 12 ft. 3. 12 ft. WELL'S STATIC WATER LEVEL 12 ft. below land surface measured on mo/day/yr 2-13-90 Pump test data: Well water was _____ ft. after _____ hours pumping _____ gpm Est. Yield _____ gpm: Well water was _____ ft. after _____ hours pumping _____ gpm Bore Hole Diameter 11 in. to _____ ft., and _____ in. to _____ ft. WELL WATER TO BE USED AS: 5 Public water supply 8 Air conditioning 11 Injection well 1 Domestic 3 Feedlot 6 Oil field water supply 9 Dewatering 12 Other (Specify below) 2 Irrigation 4 Industrial 7 Lawn and garden only 10 Monitoring well Was a chemical/bacteriological sample submitted to Department? Yes _____ No X ; If yes, mo/day/yr sample was submitted _____ Water Well Disinfected? Yes X No								
			5 TYPE OF BLANK CASING USED: 1 Steel 3 RMP (SR) 5 Wrought iron 8 Concrete tile CASING JOINTS: Glued X Clamped _____ 2 PVC 4 ABS 6 Asbestos-Cement 9 Other (specify below) Welded _____ Blank casing diameter 5 in. to 20 ft., Dia. _____ in. to _____ ft., Dia. _____ in. to _____ ft. Casing height above land surface 12 in., weight 1.59 lbs./ft. Wall thickness or gauge No. 203 TYPE OF SCREEN OR PERFORATION MATERIAL: 7 PVC 10 Asbestos-cement 1 Steel 3 Stainless steel 5 Fiberglass 8 RMP (SR) 11 Other (specify) _____ 2 Brass 4 Galvanized steel 6 Concrete tile 9 ABS 12 None used (open hole) SCREEN OR PERFORATION OPENINGS ARE: 5 Gauzed wrapped 8 Saw cut 11 None (open hole) 1 Continuous slot 3 Mill slot 6 Wire wrapped 9 Drilled holes 2 Louvered shutter 4 Key punched 7 Torch cut 10 Other (specify) _____ SCREEN-PERFORATED INTERVALS: From 20 ft. to 27 ft., From _____ ft. to _____ ft. GRAVEL PACK INTERVALS: From 20 ft. to 27 ft., From _____ ft. to _____ ft.								
										6 GROUT MATERIAL: 1 Neat cement 2 Cement grout 3 Bentonite 4 Other _____ Grout Intervals: From 4 ft. to 20 ft., From _____ ft. to _____ ft. What is the nearest source of possible contamination: 10 Livestock pens 14 Abandoned water well 1 Septic tank 4 Lateral lines 7 Pit privy 11 Fuel storage 15 Oil well/Gas well 2 Sewer lines 5 Cess pool 8 Sewage lagoon 12 Fertilizer storage 16 Other (specify below) 3 Watertight sewer lines 6 Seepage pit 9 Feedyard 13 Insecticide storage Direction from well? Northwest How many feet? 62	
FROM		TO		LITHOLOGIC LOG		FROM		TO		PLUGGING INTERVALS	
0		3		topsoil							
3		13		clay							
13		21		fine sand							
21		27		medium sand							
7 CONTRACTOR'S OR LANDOWNER'S CERTIFICATION: This water well was (1) constructed, (2) reconstructed, or (3) plugged under my jurisdiction and was completed on (mo/day/year) 2-13-90 and this record is true to the best of my knowledge and belief. Kansas Water Well Contractor's License No. 236 This Water Well Record was completed on (mo/day/yr) 5-5-90 under the business name of Harp Well and Pump Service, Inc. by (signature) <i>Mary Arnold</i>											
INSTRUCTIONS: Use typewriter or ball point pen. PLEASE PRESS FIRMLY and PRINT clearly. Please fill in blanks, underline or circle the correct answers. Send top three copies to Kansas Department of Health and Environment, Bureau of Water Protection, Topeka, Kansas 66620-7320. Telephone: 913-296-5514. Send one to WATER WELL OWNER and retain one for your records.											

OFFICE USE ONLY

T

R

EW

SEC.

1/4

1/4

1/4