

CORRECTION TO WATER WELL RECORD (WWC-5)

The following correction(s) was made to the attached WWC-5 log, in order to file the item or to rectify lacking or incorrect information.

Fraction (1/4 1/4 1/4) Section-Township-Range changed:

listed as 9-29S-1E

changed to SW SW NE, 8-29S-1E

Other changes: Initial statements: _____

Changed to: _____

Comments: _____

verification method: well address on form, Wichita city map, and

Derby 1:24,000 topo. map. initials: DRL date: 10/11/2001

submitted by: Kansas Geological Survey, Data Resources Library, 1930 Constant Ave., Lawrence, KS 66047-3726
to: Kansas Dept of Health & Environment Bureau of Water Industrial Programs, Bldg 283, Forbes Field, KS 66620


USE TYPEWRITER OR BALL POINT PEN-PRESS FIRMLY, PRINT CLEARLY.

T R EW sec 1/4 1/4 1/4 No.

WATER WELL RECORD
KSA 82a-1201-1215

Kansas State Dept. Of Health
(Water Well Contractors)
Forbes-Bldg. 740
Topeka, Kansas 66620

1 Location of well:	County Sedgwick	Township name Salem	Fraction	Section number 9	Town number 29S	Range number 1E
Distance and direction from nearest town or city: 401 West 83 South			3 Owner of well: Brian K. Lloyd			
Street address of well location if in city: Wichita, Kansas			Address: 401 West 83 Street South Wichita, Kansas			

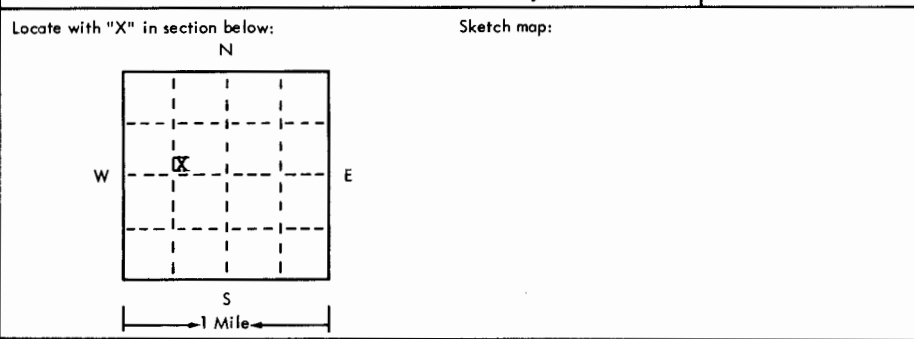

4 Well depth: **45** ft. Date of completion **4-1-75**
Well diameter **11** in.

5 Cable tool Rotary Driven Dug
 Hollow rod Jetted Bored Reverse rotary

6 Use: Domestic Public supply Industry
 Irrigation Air conditioning Commercial
 Test well

7 Casing: Material **Styrene** above/below
Threaded Welded Surface **12** in.
Diam. **45** Weight **12** lbs./ft.
2 in. to **45** ft. depth Drive shoe? Yes No
5 in. to **45** ft. depth!

2 Type and color of material	From	To
Sandy Soil and Dirt	0	5
Clay Balls and Sand	5	20
Fine Sand	20	30
Medium Coarse Sand	30	45

8 Screen: **Sunflower Plastic**
Manufacturer **Styrene** Dia. **5"**
Type **Styrene** Dia. **5"**
Slot/gauze **.005** Length **15'**
Set between **30** ft. and **45** ft.
Fittings: Gravel pack Yes No Size range of material **1/2-1/8"**

9 Static water level: **15** ft. below land surface Date **4-1-75**

10 Pumping level below land surfaces:
____ ft. after ____ hrs. pumping ____ g.p.m.
____ ft. after ____ hrs. pumping ____ g.p.m.
Estimated maximum yield ____ g.p.m.

11 Water sample submitted: Yes No Date ____

12 Well head completion: Pitless adapter **12** Inches above grade **capped**

13 Well grouted? Yes No
 Neat cement Bentonite
Depth: From **0** ft. to **12** ft.

14 Nearest source of possible contamination: **80** ft. **SE** **Septic tank**
Direction **SE** Type **Septic tank**
Well disinfected upon completion? Yes No

15 Pump: Not installed
Manufacturer's name _____
Model number _____ HP _____ Volts _____
Length of drop pipe _____ ft. capacity _____ g.m.p.
Type:
 Submersible Turbine
 Jet Reciprocating
 Centrifugal Other

16 Remarks: elevation

(use a second sheet if needed)

Topography:
 Hill
 Slope
 Upland
 Valley

17 Water well contractor's certification:
This well was drilled under my jurisdiction and this report is true to the best of my knowledge and belief.
Harp Well & Pump 236
Business name **Wichita, Kansas** License No. **87209**
Address **Wichita, Kansas**
Signed *Mrs. Arnold* Date **4-1-75**
Authorized representative

Forward the white, blue and pink copies to the Kansas State Dept. Of Health.