USE TYPEWRITER OR BALL POINT PEN-PRESS FIRMLY, PRINT CLEARLY.

T	R	EW	sec 1/4 1/4 1/4 No.							

WATER WELL RECORD
KSA 82a-1201-1215

Kansas State Dept. Of Health
(Water Well Contractors)
Forbes-Bldg. 740
Topeka, Kansas 66620

NE SE SE NW

1 Location of well:	County	Township name	Fraction	Section number	Town number	Range number
	SEDGWICK	SALEM	~~SW~~ 1/4 ~~NE~~ 1/4	11	T29S	R1E

Distance and direction from nearest town or city: 1/2 MILE WEST OF DERBY KANS

Street address of well location if in city: 8330 HANCOCK DERBY KANS

3 Owner of well: CAMELOT CONSTRUCTION INC.

Address: 706 N MAIN WICHITA KAN 67202

Locate with "X" in section below:

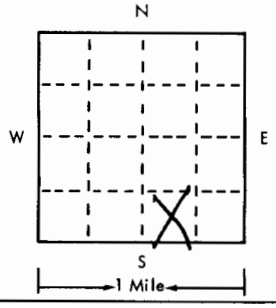

Sketch map: DRILLED 8" HOLE TO 4 FT. INSTALLED 4" CASING - GROUTED CASING

4 Well depth: 16.5 ft. Date of completion 7/14/75
Well diameter 8 in.

5 ☐ Cable tool ☐ Rotary ☒ Driven ☐ Dug
☐ Hollow rod ☐ Jetted ☒ Bored ☐ Reverse rotary

6 Use: ☒ Domestic ☐ Public supply ☐ Industry
☐ Irrigation ☐ Air conditioning ☐ Commercial
☐ Test well ☐

7 Casing: Material PVP Height: (above) below BASEMENT FLOOR - BASEMENT 6' DEEP
Threaded ☐ Welded ☒ Surface 12 in.
Diam. SOL Weight 1.55 lbs./ft.
4 in. to 5 ft. depth Drive shoe? ☐ Yes ☒ No
in. to ft. depth

2 Type and color of material	From	To
MEDIUM SAND TAN COLOR ~~BROWN~~	0	3.5
WATER BEARING SAND H_2O	3.5	4
DROVE 1.25 GALV PIPE	4'	
WITH POINT TO —	16.5	

(use a second sheet if needed)

8 Screen:
Manufacturer CLAYTON MARK
Type BRASS Dia. 1.25
Slot (gauze) .060 Length 4 FT.
Set between 12.5 ft. and 16.5 ft.
Fittings: GALV. IRON PIPE & COUP
Gravel pack ☐ Yes ☒ No Size range of material

9 Static water level: FROM BASEMENT FLOOR
3.5 ft. below land surface Date 7/18/75

10 Pumping level below land surfaces:
ft. after hrs. pumping N/A g.p.m.
ft. after hrs. pumping g.p.m.
Estimated maximum yield 50 g.p.m.

11 Water sample submitted:
☐ Yes ☒ No Date

12 Well head completion: 12" BASEMENT FLOOR
☐ Pitless adapter ☒ Inches above grade

13 Well grouted? ☒ Yes ☐ No
☒ Neat cement ☐ Bentonite ☐
Depth: From 0 ft. to 4 ft.

14 Nearest source of possible contamination: WATER LINE
ft. 11 Direction NORTH Type PLASTIC SEWER
Well disinfected upon completion? ☒ Yes ☐ No

15 Pump: ☐ Not installed
Manufacturer's name FYW
Model number 7CP HP .75 Volts 230
Length of drop pipe 16.5 ft. capacity 18 g.m.p.
Type:
☐ Submersible ☐ Turbine
☒ Jet ☐ Reciprocating
☐ Centrifugal ☐ Other

16 Remarks: elevation 1300 FT.

Topography:
☐ Hill
☐ Slope
☐ Upland
☒ Valley

17 Water well contractor's certification:
This well was drilled under my jurisdiction and this report is true to the best of my knowledge and belief.
Business name BEARDEN PUMP & WELL 104 License No.
Address 3112 MENTOR W. CHITA
Signed Otis W Bearden Date 8/30/75
Authorized representative

Forward the white, blue and pink copies to the Kansas State Dept. Of Health.

Form WWC-5

677-H