

USE TYPEWRITER OR BALL POINT PEN-PRESS FIRMLY, PRINT CLEARLY.

T R EW sec 1/4 1/4 1/4 No.

NE SE SE NW


WATER WELL RECORD
KSA 92a-1201-1215

Kansas State Dept. Of Health
(Water Well Contractors)
Forbes-Bldg. 740
Topeka, Kansas 66620

SW 1/4 SE 1/4
OF SEC. 11 IN

1 Location of well: County **SEDGWICK** Township name **SALEM** Section number **11** Town number **T2950.** Range number **R1E**

Distance and direction from nearest town or city: **1/2 MILE WEST OF DERBY KS** 3 Owner of well: **CAMELOT CONSTRUCTION**
Street address of well location if in city: **8344 PEACH LANE DERBY, KS** Address: **706 N. MAIN - WILHITA KS**

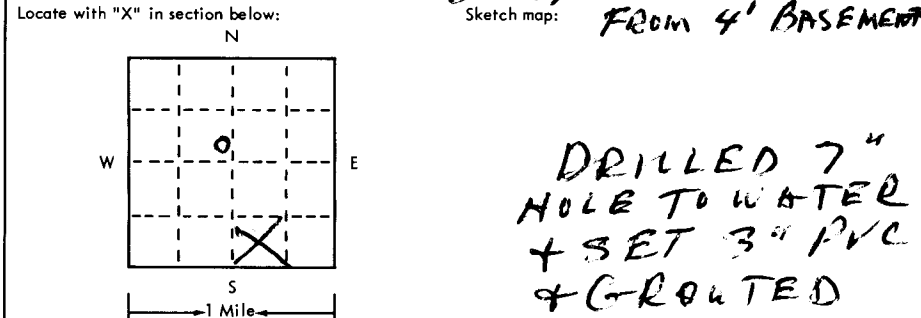

Well depth: **19** ft. Date of completion: **1-13-75**
Well diameter: **7"** in.

5 Cable tool Rotary Driven Dug
 Hollow rod Jetted Bored Reverse rotary

6 Use: Domestic Public supply Industry
 Irrigation Air conditioning Commercial
 Test well

7 Casing: Material **PVC** Height: **above**
Threaded Welded Surface **12** in. **Basement Floor**
Diam. **3"** Weight **147** lbs./ft.
3 in. to **8** ft. depth Drive shoe? Yes No

2	Type and color of material	From	To
	BLACK SOIL SOME CLAY	1	3
	BROWN CLAY + SAND MIXED	3	5
	GRAY SANDY CLAY	5	6
	GRAY SAND - + WATER	6	7
	Water at 6 1/2'		
	Drone Rest of Distance		

8 Screen: Manufacturer **MIDWEST**
Type **SAND PT.** Dia. **1 1/4"**
Slot gauge **60** Length **4'**
Set between **15** ft. and **19** ft.
Fittings: **CALL IRON PIPE + CO.**
Gravel pack Yes No Size range of material

9 Static water level: **10 1/2' FROM LAND**
6 1/2' FROM BASE Date **1-13-75**

10 Pumping level below land surface: **NO TEST RUN**
ft. after ___ hrs. pumping ___ g.p.m.
ft. after ___ hrs. pumping ___ g.p.m.
Estimated maximum yield **40** g.p.m.

11 Water sample submitted: Yes No Date

12 Well head completion: **12"**
 Pitless adapter Inches above grade

13 Well grouted? Yes No
 Neat cement Monite
Depth: From **0** ft. to **7** ft.

14 Nearest source of possible contamination: **WATER TOWER EAST**
ft. **10** Direction **N DRIFT TIGHT** type **Fe**
Well disinfected upon completion? Yes No

15 Pump: Not installed
Manufacturer's name **(F+L) Flint + Walling**
Model number **FLPDS** HP **3/4** Volts **220**
Length of drop pipe **19** ft. capacity **40 g.p.m.**
Type: Submersible Turbine
 Jet Reciprocating
 Centrifugal Other

16 Remarks: elevation **1300 ft.**

Topography:
 Hill
 Slope
 Upland
 Valley

17 Water well contractor's certification:
This well was drilled under my jurisdiction and this report is true to the best of my knowledge and belief.

BEARDEN PUMP + WELL
Business name License No. **104**
Address **3147 MENTOR WILHITA**
Signed **High Bearden** Date **2/10/75**
Authorized representative

Forward the white, blue and pink copies to the Kansas State Dept. Of Health.

Form WWC-5