USE TYPEWRITER OR BALL POINT PEN-PRESS FIRMLY, PRINT CLEARLY.

T R EW sec 1/4 1/4 1/4 No.

WATER WELL RECORD
KSA 82a-1201-1215

Kansas State Dept. Of Health
(Water Well Contractors)
Forbes-Bldg. 740
Topeka, Kansas 66620

SE NE SE NW

1 Location of well:	County	Township name	Fraction	Section number	Town number	Range number
	SEDGWICK	SALEN	~~SW~~ 1/4 ~~SE~~ 1/4	11	T29S	R1E

Distance and direction from nearest town or city: 1/2 MILE WEST OF DERBY KANS

Street address of well location if in city: 8260 HANCOCK DRIVE DERBY KANS.

3 Owner of well: CAMELOT CONSTRUCTION INC.

Address: 706 N MAIN WICHITA KS. 67202

Locate with "X" in section below:

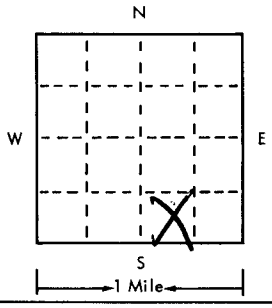

Sketch map: DRILLED 8" HOLE TO 4 FT. INSTALLED 4" CASING + GROUTED CASING.

4 Well depth: 165 ft. Date of completion 2/26/76
Well diameter 8 in.

5 ☐ Cable tool ☐ Rotary ☒ Driven ☐ Dug
☐ Hollow rod ☐ Jetted ☒ Bored ☐ Reverse rotary

6 Use: ☒ Domestic ☐ Public supply ☐ Industry
☐ Irrigation ☐ Air conditioning ☐ Commercial
☐ Test well ☐

7 Casing: Material RAP Height: Above/below BASEMENT FLOOR
Threaded ☐ Welded ☒ Surface 12 in.
Diam. SCL Weight 155 lbs./ft.
4 in. to 5 ft. depth Drive shoe? ☐ Yes ☒ No
in. to ft. depth

8 Screen:
Manufacturer MIDWEST
Type BRASS Dia. 1.25
Slot (gauze) .060 Length 4 FT.
Set between 1.5 ft. and 165 ft.
Fittings: GALV PIPE + COUPLINGS
Gravel pack ☐ Yes ☒ No Size range of material FROM BASEMENT

9 Static water level: 3.5 ft. below land surface Date 2/25/76

10 Pumping level below land surface:
ft. after hrs. pumping NA g.p.m.
ft. after hrs. pumping g.p.m.
Estimated maximum yield 50 g.p.m.

11 Water sample submitted:
☐ Yes ☒ No Date

12 Well head completion: 12" BASEMENT FLOOR
☐ Pitless adapter ☒ Inches above grade

13 Well grouted? ☒ Yes ☐ No
☒ Neat cement ☐ Bentonite ☐
Depth: From 0 ft. to 4 ft.

14 Nearest source of possible contamination:
ft. 22 Direction SE Type PLASTIC SEWER
Well disinfected upon completion? ☒ Yes ☐ No

15 Pump: ☐ Not installed
Manufacturer's name FTW
Model number 7CP5 HP 1.75 Volts 230
Length of drop pipe 16.5 ft. capacity 18 g.m.p.
Type:
☐ Submersible ☐ Turbine
☒ Jet ☐ Reciprocating
☐ Centrifugal ☐ Other

2 Type and color of material	From	To
SAND, MEDIUM TAN	0	3.5
WATER BEARIN SAND - BROWN H2O	3.5	4'
DRIVE 1.25 GALV. PIPE	4	
WITH SAND POINT TO -		165

(use a second sheet if needed)

16 Remarks: elevation 1300 FT.

Topography:
☐ Hill
☐ Slope
☐ Upland
☒ Valley

17 Water well contractor's certification:
This well was drilled under my jurisdiction and this report is true to the best of my knowledge and belief.

Business name BEARDEN PUMP + WELL License No. 104
Address 3147 MENTOR
Signed DISW Bearden Date 2/26/76
Authorized representative

Forward the white, blue and pink copies to the Kansas State Dept. Of Health.

Form WWC-5

677-H

BASEMENT 6 FT DEEP

T 29 R1E Sec 11 SW-SE WICHITA KS