USE TYPEWRITER OR BALL POINT PEN-PRESS FIRMLY, PRINT CLEARLY.

WATER WELL RECORD
KSA 82a-1201-1215

Kansas Department of Health and Environment-Division of Environment
(Water well Contractors)
Topeka, Kansas 66620

SW SW NE NW

1. Location of well: County: Sedgwick | Fraction: 1/4 1/4 1/4 | Section number: 11 | Township number: T 29 S | Range number: R 1 E W

2. Distance and direction from nearest town or city:
Street address of well location if in city: 8145 Millsap Derby, Kansas

3. Owner of well: Stephen West
R.R. or street: 2927 South Vine
City, state, zip code: Derby, Kansas

4. Locate with "X" in section below: Sketch map:

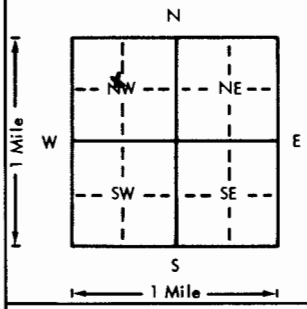

6. Bore hole dia. 11 in. Completion date
Well depth 35 ft. 1-3-76

7. __ Cable tool X Rotary __ Driven __ Dug
__ Hollow rod __ Jetted __ Bored __ Reverse rotary

8. Use: X Domestic __ Public supply __ Industry
__ Irrigation __ Air conditioning __ Stock
__ Lawn __ Oil field water __ Other

9. Casing: Material: Styrene Height: Above or below
Threaded __ Welded __ Surface 12 in.
RMP X PVC __ Weight __ lbs./ft.
Dia. 5 in. to 35 ft. depth Wall Thickness: inches or
Dia. __ in. to __ ft. depth gage No. 200

5. Type and color of material	From	To
Dirt	0	3
Clay	3	14
Medium Sand	14	26
Blue Shale	26	35

(Use a second sheet if needed)

10. Screen: Manufacturer's name Sunflower Plastics
Type Styrene Dia. 5"
Slot/gauze .06 Length 15'
Set between 20 ft. and 35 ft.
ft. and ft.
Gravel pack? yes Size range of material #4-#8

11. Static water level: mo./day/yr.
15 ft. below land surface Date 1-3-76

12. Pumping level below land surfaces:
ft. after hrs. pumping g.p.m.
ft. after hrs. pumping g.p.m.
Estimated maximum yield g.p.m.

13. Water sample submitted: mo./day/yr.
__ Yes __ No Date

14. Well head completion: Capped
__ Pitless adapter 12 Inches above grade

15. Well grouted? yes
With: __ Neat Cement __ Bentonite X Concrete
Depth: From 40' to 14 ft.

16. Nearest source of possible contamination: Septic
ft. 60 Direction SW Type
Well disinfected upon completion? X Yes __ No

17. Pump: X Not installed
Manufacturer's name
Model number HP Volts
Length of drop pipe ft. capacity g.p.m.
Type:
__ Submersible __ Turbine
__ Jet __ Reciprocating
__ Centrifugal __ Other

18. Elevation:
Topography:
__ Hill
X Slope
__ Upland
__ Valley

19. Remarks:

20. Water well contractor's certification:
This well was drilled under my jurisdiction and this report is true to the best of my knowledge and belief.
Harp Well + Pump 236
Business name License No.
Address Wichita, Kansas
Signed M. Arnold Date 1-6-76
Authorized representative

Forward the white, blue and pink copies to the Department of Health and Environment

Form WWC-5

M1-1023

T 29 R 1 E W Sec 11 SE NW NW 1/4 1/4 1/4