USE TYPEWRITER OR BALL POINT PEN-PRESS FIRMLY, PRINT CLEARLY.

# WATER WELL RECORD
KSA 82a-1201-1215

Kansas Department of Health and Environment-Division of Environment
(Water well Contractors)
Topeka, Kansas 66620

SW NE NE NW

1. Location of well: County: Sedgwick | Fraction: 1/4 SE 1/4 NW 1/4 | Section number: 11 | Township number: T 29 S | Range number: R 1 E W

2. Distance and direction from nearest town or city: 3802 Haven Dr.
Street address of well location if in city: Derby, Kans

3. Owner of well: M & H Construction
R.R. or street: Box 345
City, state, zip code: Derby, Kansas

4. Locate with "X" in section below: Sketch map:

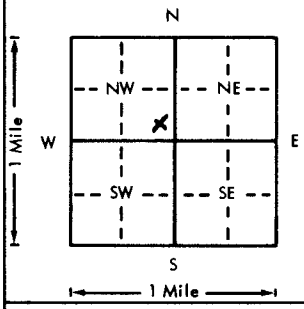


6. Bore hole dia. 11 in. Completion date 11-20-15
Well depth 38 ft.

7. Cable tool X Rotary Driven Dug
Hollow rod Jetted Bored Reverse rotary

8. Use: X Domestic Public supply Industry
Irrigation Air conditioning Stock
Lawn Oil field water Other

9. Casing: Manufacturer Stepene Height Above or below
Threaded Welded X Surface 12 in.
RMP X PVC Weight lbs./ft.
Dia 5 in. to 38 ft. depth Wall Thickness: inches or
Dia. in. to ft. depth gage No. 200

| 5. Type and color of material | From | To |
|---|---|---|
| Sandy Topsoil | 0 | 3 |
| Fine Sand | 3 | 15 |
| Medium Sand | 15 | 24 |
| Blue Shale | 24 | 38 |

10. Screen: Manufacturer's name Sunflower Plastic
Type Stepene Dia. 5"
Slot/gauze .06 Length [redacted] 13'
Set between [redacted] 25 ft. and 38 ft.
ft. and ft.
Gravel pack? Yes Size range of material

11. Static water level: mo./day/yr.
20 ft. below land surface Date 11-20-15

12. Pumping level below land surfaces:
ft. after hrs. pumping g.p.m.
ft. after hrs. pumping g.p.m.
Estimated maximum yield g.p.m.

13. Water sample submitted: mo./day/yr.
Yes No Date

14. Well head completion: Capped
Pitless adapter 12 Inches above grade

15. Well grouted? Yes
With: Neat cement Bentonite X Concrete
Depth: From 40" to 14 ft.

16. Nearest source of possible contamination: None
ft. Direction Type
Well disinfected upon completion? X Yes No

17. Pump: X Not installed
Manufacturer's name
Model number HP Volts
Length of drop pipe ft. capacity g.p.m.
Type:
Submersible Turbine
Jet Reciprocating
Centrifugal Other

(Use a second sheet if needed)

18. Elevation:
Topography:
Hill
X Slope
Upland
Valley

19. Remarks: No apparent source for contamination.
Septic Tank to be installed at later date.

20. Water well contractor's certification:
This well was drilled under my jurisdiction and this report is true to the best of my knowledge and belief.
Harp Well & Pump 236
Business name License No.
Address Wichita, Kansas
Signed M. Arnold 11-22-15
Authorized representative

29 - 1 E W
T R
11
Sec
SE SE SE
1/4 1/4 1/4

Forward the white, blue and pink copies to the Department of Health and Environment

Form WWC-5

MI-1023