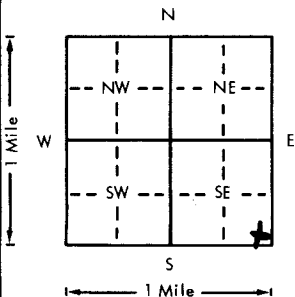
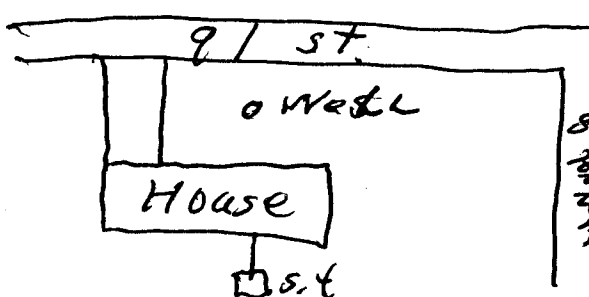


USE TYPEWRITER OR BALL
POINT PEN-PRESS FIRMLY,
PRINT CLEARLY.

WATER WELL RECORD
KSA 82a-1201-1215

Kansas Department of Health and
Environment-Division of Environment
(Water well Contractors)
Topeka, Kansas 66620

NW NE NE SE

1. Location of well:	County Sedgewick	Fraction NE 1/4 NE 1/4 SE 1/4	Section number 17	Township number T 29 S	Range number R 1 E
2. Distance and direction from nearest town or city:	4 BLK NO OF WACO		3. Owner of well: L. J. MILLER	1295 9th St So WICHITA, KS 67233	
4. Locate with "X" in section below:	Sketch map:		6. Bore hole dia. 8 3/4 in. Completion date 8-14-78 Well depth 32 ft.		
			7. Cable tool ☒ Rotary ☐ Driven ☐ Dug ☐ Hollow rod ☐ Jetted ☐ Bored ☐ Reverse rotary		
5. Type and color of material	From	To	8. Use: ☒ Domestic ☐ Public supply ☐ Industry ☐ Irrigation ☐ Air conditioning ☐ Stock ☐ Lawn ☐ Oil field water ☐ Other		
TOP SOIL	0	4	9. Casing: Material PVC Height: Above or below 0 Threaded ☐ Welded ☐ Surface ☒ 20 in. RMP ☐ PVC GL Weight ☐ lbs./ft. Dia. 5 in. to 20 ft. depth Wall Thickness: inches or Dia. ☐ in. to ☐ ft. depth gage No. 258		
SAND	4	20	10. Screen: Manufacturer's name M.P.H. Type P.V.C. Dia. 5 Slot gauze 25/100 Length 10 Set between 20 ft. and 30 ft. ft. and ☐ ft.		
GRAVEL	20	30	Gravel pack? yes Size range of material 1/4 X 3/8		
			11. Static water level: ☐ mo./day/yr. 16 ft. below land surface Date 8-14-78		
			12. Pumping level below land surfaces: ft. after ☐ hrs. pumping ☐ g.p.m. ft. after ☐ hrs. pumping ☐ g.p.m. Estimated maximum yield 40 g.p.m.		
			13. Water sample submitted: ☐ mo./day/yr. ☐ Yes ☒ No Date 8-14-78		
			14. Well head completion: CAP ☐ Pitless adapter 20 inches above grade		
			15. Well grouted? yes With: ☒ Neat cement ☐ Bentonite ☐ Concrete Depth: From 0 ft. to 12 ft.		
			16. Nearest source of possible contamination: ft. 70 Direction SE Type Septic Well disinfected upon completion? ☒ Yes ☐ No		
			17. Pump: ☒ Not installed Manufacturer's name ☐ Model number ☐ HP ☐ Volts ☐ Length of drop pipe ☐ ft. capacity ☐ g.p.m. Type: ☐ Submersible ☐ Turbine ☐ Jet ☐ Reciprocating ☐ Centrifugal ☐ Other		
18. Elevation:	19. Remarks:		20. Water well contractor's certification: This well was drilled under my jurisdiction and this report is true to the best of my knowledge and belief. PREWITT CONEST 353 Business name BOY 744 License No. ☐ Address ☐ Signed PREWITT Date 8-14-78 Authorized representative		

Forward the white, blue and pink copies to the Department of Health and Environment

Form WWC-5