

1 LOCATION OF WATER WELL: Fraction SE 1/4 SE 1/4 NW 1/4 Section Number 18 Township Number T 29 S Range Number R 1E E
 County: Sedgewick
 Distance and direction from nearest town or city street address of well if located within city? 2 So Haysville KS.

2 WATER WELL OWNER:

RR#, St. Address, Box #

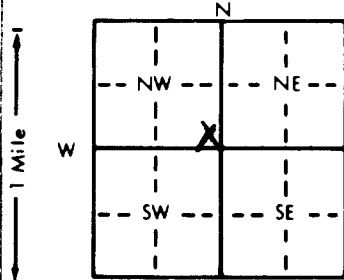
City, State, ZIP Code

Pat Murphy
9131 Stearns
Haysville, KS 67233

Board of Agriculture, Division of Water Resources

Application Number:

3 LOCATE WELL'S LOCATION WITH AN "X" IN SECTION BOX:

4 DEPTH OF COMPLETED WELL: 57 ft. ELEVATION:Depth(s) Groundwater Encountered 1 34 ft. 2. ft. 3. ft.WELL'S STATIC WATER LEVEL 34 ft. below land surface measured on 6-18-90 mo/day/yrPump test data: Well water was 34 ft. after 30 hours pumping 30 gpmEst. Yield 50 gpm: Well water was 34 ft. after 30 hours pumping 30 gpmBore Hole Diameter 11 in. to 57 ft. and 57 in. to 57 ft.

WELL WATER TO BE USED AS: 5 Public water supply 8 Air conditioning 11 Injection well

1 Domestic 3 Feedlot 6 Oil field water supply 9 Dewatering 12 Other (Specify below)

2 Irrigation 4 Industrial 7 Lawn and garden only 10 Monitoring well

Was a chemical/bacteriological sample submitted to Department? Yes X No X; If yes, mo/day/yr sample was submittedWater Well Disinfected? Yes X No X

5 TYPE OF BLANK CASING USED:

1 Steel 3 RMP (SR) 5 Wrought iron 8 Concrete tile CASING JOINTS: Glued X Clamped

2 PVC 4 ABS 6 Asbestos-Cement 9 Other (specify below) Welded

Blank casing diameter 5 in. to 40 ft. Dia 5 in. to 40 ft. Dia 5 in. to 40 ft. DiaCasing height above land surface 12 in. weight 1.59 lbs./ft. Wall thickness or gauge No. SDR-26

TYPE OF SCREEN OR PERFORATION MATERIAL:

1 Steel 3 Stainless steel 5 Fiberglass 7 PVC 10 Asbestos-cement

2 Brass 4 Galvanized steel 6 Concrete tile 8 RMP (SR) 11 Other (specify)

SCREEN OR PERFORATION OPENINGS ARE: 9 ABS 12 None used (open hole)

1 Continuous slot 3 Mill slot 5 Gauzed wrapped 8 Saw cut 11 None (open hole)

2 Louvered shutter 4 Key punched 6 Wire wrapped 9 Drilled holes

SCREEN-PERFORATED INTERVALS: From 40 ft. to 57 ft. From 40 ft. to 57 ft. From 40 ft. to 57 ft.GRAVEL PACK INTERVALS: From 23 ft. to 57 ft. From 23 ft. to 57 ft. From 23 ft. to 57 ft.From OR LANDOWNER'S CERTIFICATION: This water well was (1) constructed, (2) reconstructed, or (3) plugged under my jurisdiction and was completed on (mo/day/year) 6-18-90 and this record is true to the best of my knowledge and belief. KansasWater Well Contractor's License No. 318 This Water Well Record was completed on (mo/day/yr) 7-2-90under the business name of Weninger Dully by (signature) [Signature]