USE TYPEWRITER OR BALL POINT PEN-PRESS FIRMLY, PRINT CLEARLY.

WATER WELL RECORD
KSA 82a-1201-1215

Kansas Department of Health and Environment-Division of Environment
(Water well Contractors)
Topeka, Kansas 66620

1. Location of well:	County	Fraction	Section number	Township number	Range number
	Sedgwick	NE NE 1/4 NE 1/4 NE 1/4	20	T 29 S	R 1E E/W

2. Distance and direction from nearest town or city: 9623 So. Broadway
Street address of well location if in city: Wichita, Kansas

3. Owner of well: Jack Ward
R.R. or street: 9623 South Broadway
City, state, zip code: Wichita, Kansas

4. Locate with "X" in section below:

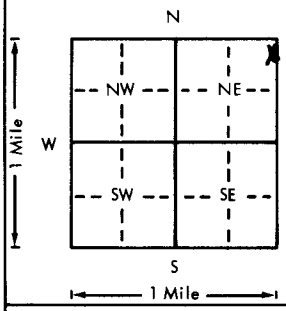

Sketch map:

5. Type and color of material	From	To
Sandy Topsoil	0	2
Sandy Clay	2	8
Fine Sand	8	16
Medium Sand	16	25
Coarse Sand	25	40

(Use a second sheet if needed)

6. Bore hole dia. 11 in. Completion date 3-5-77
Well depth 40 ft.

7. __ Cable tool X Rotary __ Driven __ Dug
__ Hollow rod __ Jetted __ Bored __ Reverse rotary

8. Use: __ Domestic __ Public supply __ Industry
__ Irrigation __ Air conditioning __ Stock
X Lawn __ Oil field water __ Other

9. Casing: Material styrene Height: Above or below ///
Threaded __ Welded gl Surface 12 in.
RMP X PVC __ Weight __ lbs./ft.
Dia. 5 in. to 40 ft. depth Wall Thickness: inches or
Dia. __ in. to __ ft. depth gage No. .200

10. Screen: Manufacturer's name Sunflower Plastic
Type styrene Dia. 5"
Slot/~~gage~~ .06 Length 10'
Set between 30 ft. and 40 ft.
__ ft. and __ ft.
Gravel pack? yes Size range of material 1-1/8"

11. Static water level: mo./day/yr.
16 ft. below land surface Date 3-5-77

12. Pumping level below land surfaces:
__ ft. after __ hrs. pumping __ g.p.m.
__ ft. after __ hrs. pumping __ g.p.m.
Estimated maximum yield __ g.p.m.

13. Water sample submitted: mo./day/yr.
__ Yes __ No Date

14. Well head completion: capped
__ Pitless adapter 12 Inches above grade

15. Well grouted? yes
With: __ Neat cement __ Bentonite X Concrete
Depth: From 40" ft. to 14 ft.

16. Nearest source of possible contamination: Horse
ft. 65 Direction west Type Lot
Well disinfected upon completion? X Yes __ No

17. Pump: X Not installed
Manufacturer's name
Model number HP Volts
Length of drop pipe ft. capacity g.p.m.
Type:
__ Submersible __ Turbine
__ Jet __ Reciprocating
__ Centrifugal __ Other

18. Elevation:
Topography:
__ Hill
__ Slope
__ Upland
__ Valley

19. Remarks: Flat Ground

20. Water well contractor's certification:
This well was drilled under my jurisdiction and this report is true to the best of my knowledge and belief.
Harp Well & Pump 236
Business name License No.
Address Wichita, Kansas
Signed M. Arnold Date 3-11-77
Authorized representative

T 29 R 1 E/W Sec 20 1/4 1/4 1/4 NENE

Forward the white, blue and pink copies to the Department of Health and Environment

Form WWC-5

MI-1023