USE TYPEWRITER OR BALL POINT PEN-PRESS FIRMLY, PRINT CLEARLY.

WATER WELL RECORD
KSA 82a-1201-1215

Kansas Department of Health and Environment-Division of Environment
(Water well Contractors)
Topeka, Kansas 66620

1. Location of well: County: Sedgwick | Fraction: NW 1/4 SW 1/4 SW 1/4 | Section number: 21 | Township number: T 29 S | Range number: R 1 E W

2. Distance and direction from nearest town or city: 1 M. So WACO Wego Ks.
Street address of well location if in city:

3. Owner of well: S. C. Billingsley
R.R. or street: BX 555
City, state, zip code: Derby, KS 67037

4. Locate with "X" in section below:

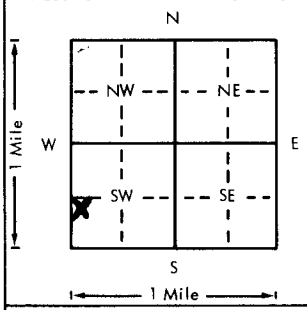

Sketch map:

6. Bore hole dia. 11 in. Completion date
Well depth 34 ft. 9/19/78

7. __ Cable tool X Rotary __ Driven __ Dug
__ Hollow rod __ Jetted __ Bored __ Reverse rotary

8. Use: X Domestic __ Public supply __ Industry
__ Irrigation __ Air conditioning __ Stock
__ Lawn __ Oil field water __ Other

9. Casing: Material Styrene Height: Above or below
Threaded __ Welded X Surface 12 in.
RMP X PVC Weight 1.50 lbs./ft.
Dia. 5 in. to 34 ft. depth Wall Thickness: inches or
Dia. __ in. to __ ft. depth gage No. .200

5. Type and color of material

	From	To
Top soil	0	2
red clay	2	12
fine to med sand	12	32
charcoal clay	32	34

(Use a second sheet if needed)

10. Screen: Manufacturer's name Sunflower
Type 200 Dia. 5 in
Slot/gauze 1/16 Length 5 ft
Set between 29 ft. and 34 ft.
ft. and ft.
Gravel pack? Yes Size range of material 3/8

11. Static water level: mo./day/yr.
19 ft. below land surface Date 9/19/78

12. Pumping level below land surfaces:
22 ft. after 1/2 hrs. pumping 15 g.p.m.
ft. after hrs. pumping g.p.m.
Estimated maximum yield 25-30 g.p.m.

13. Water sample submitted: mo./day/yr.
__ Yes X No Date

14. Well head completion:
__ Pitless adapter 12 inches above grade

15. Well grouted? Yes
With: __ Neat cement __ Bentonite X Concrete
Depth: From 3 ft. to 13 ft.

16. Nearest source of possible contamination:
ft. 100 Direction E Type Septic
Well disinfected upon completion? X Yes __ No

17. Pump: __ Not installed
Manufacturer's name Valley
Model number 18085 HP 3/4 Volts 220
Length of drop pipe 30 ft. capacity 18 g.p.m.
Type:
X Submersible __ Turbine
__ Jet __ Reciprocating
__ Centrifugal __ Other

18. Elevation:

Topography:
__ Hill
__ Slope
X Upland
__ Valley

19. Remarks: Customer to furnish 4x4x4" slab around casing at grade per State Regulations
Signature On file

20. Water well contractor's certification:
This well was drilled under my jurisdiction and this report is true to the best of my knowledge and belief.
Business name Johnson Drilling License No. 318
Address Colorado
Signed Johnson Authorized representative 9/19/78

Forward the white, blue and pink copies to the Department of Health and Environment

Form WWC-5

MI-1023

T 29 R 1 E Sec 1/4 1/4 1/4 1/4