MW-2

WATER WELL RECORD Form WWC-5 KSA 82a-1212

1 LOCATION OF WATER WELL:	Fraction	Section Number	Township Number	Range Number
County: SEDGWICK	SW ¼ SW ¼ SE ¼	1	T 29 S	R 1 E/W

Distance and direction from nearest town or city street address of well if located within city? EAST
K-15 SERVICE 620 N BALTIMORE DERBY KS

2 WATER WELL OWNER: CONFEDERATED CONSTRUCTION
RR#, St. Address, Box # : 503 N BUCKNER
City, State, ZIP Code ATT GENNY WILKES DERBY KS 67037

Board of Agriculture, Division of Water Resources
Application Number:

3 LOCATE WELL'S LOCATION WITH AN "X" IN SECTION BOX:

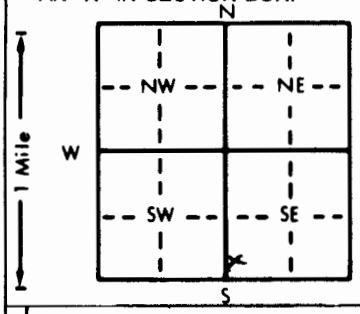

4 DEPTH OF COMPLETED WELL 60 ft. ELEVATION:
Depth(s) Groundwater Encountered 1. 50 ft. 2. — ft. 3. — ft.
WELL'S STATIC WATER LEVEL 48.79 ft. below land surface measured on mo/day/yr 12-21-93
Pump test data: Well water was — ft. after — hours pumping — gpm
Est. Yield — gpm: Well water was — ft. after — hours pumping — gpm
Bore Hole Diameter 7.25 in. to 60 ft., and — in. to — ft.
WELL WATER TO BE USED AS: 5 Public water supply 8 Air conditioning 11 Injection well
1 Domestic 3 Feedlot 6 Oil field water supply 9 Dewatering 12 Other (Specify below)
2 Irrigation 4 Industrial 7 Lawn and garden only 10 Monitoring well —
Was a chemical/bacteriological sample submitted to Department? Yes — No X; If yes, mo/day/yr sample was submitted —
Water Well Disinfected? Yes — No X

5 TYPE OF BLANK CASING USED: 5 Wrought iron 8 Concrete tile CASING JOINTS: Glued — Clamped —
1 Steel 3 RMP (SR) 6 Asbestos-Cement 9 Other (specify below) Welded —
2 PVC 4 ABS 7 Fiberglass — Threaded X
Blank casing diameter 2 in. to 38.5 ft., Dia — in. to — ft., Dia — in. to — ft.
Casing height above land surface FLUSH Ø in., weight SCH 40 lbs./ft. Wall thickness or gauge No. —
TYPE OF SCREEN OR PERFORATION MATERIAL: 7 PVC 10 Asbestos-cement
1 Steel 3 Stainless steel 5 Fiberglass 8 RMP (SR) 11 Other (specify) —
2 Brass 4 Galvanized steel 6 Concrete tile 9 ABS 12 None used (open hole)
SCREEN OR PERFORATION OPENINGS ARE: 5 Gauzed wrapped 8 Saw cut 11 None (open hole)
1 Continuous slot 3 Mill slot 6 Wire wrapped 9 Drilled holes
2 Louvered shutter 4 Key punched 7 Torch cut 10 Other (specify) —
SCREEN-PERFORATED INTERVALS: From 38.5 ft. to 58.5 ft., From — ft. to — ft.
From — ft. to — ft., From — ft. to — ft.
~~GRAVEL~~ SAND PACK INTERVALS: From 34 ft. to 60 ft., From — ft. to — ft.
From — ft. to — ft., From — ft. to — ft.

6 GROUT MATERIAL: 1 Neat cement 2 Cement grout 3 Bentonite 4 Other —
Grout Intervals: From 2 G.L. ft. to 31 ft., From 31 ft. to 34 ft., From — ft. to — ft.
What is the nearest source of possible contamination: 10 Livestock pens 14 Abandoned water well
1 Septic tank 4 Lateral lines 7 Pit privy 11 Fuel storage 15 Oil well/Gas well
2 Sewer lines 5 Cess pool 8 Sewage lagoon 12 Fertilizer storage 16 Other (specify below)
3 Watertight sewer lines 6 Seepage pit 9 Feedyard 13 Insecticide storage CONTAMINATED SITE
Direction from well? — How many feet? —

FROM	TO	LITHOLOGIC LOG	FROM	TO	PLUGGING INTERVALS
GL	2	SOIL + GRAVEL			
2	6	CLAY SILT			
6	19	SILTY CLAY			
19	24	SANDY CLAY			
24	25	CLAY SAND WITH ORANGE SAND			
25	33	SANDY CLAY			
33	43	SILTY CLAY			
43	50	SANDY CLAY			
50	60	SAND			
TD	60				

7 CONTRACTOR'S OR LANDOWNER'S CERTIFICATION: This water well was (1) constructed, (2) reconstructed, or (3) plugged under my jurisdiction and was completed on (mo/day/year) 12-07-93 and this record is true to the best of my knowledge and belief. Kansas Water Well Contractor's License No. 479 This Water Well Record was completed on (mo/day/yr) 12-28-93
under the business name of EBBERTS DRILLING by (signature) Gregory Ebbert

INSTRUCTIONS: Use typewriter or ball point pen. *PLEASE PRESS FIRMLY* and *PRINT* clearly. Please fill in blanks, underline or circle the correct answers. Send top three copies to Kansas Department of Health and Environment, Bureau of Water, Topeka, Kansas 66620-0001. Telephone: 913-296-5545. Send one to WATER WELL OWNER and retain one for your records.

OFFICE USE ONLY