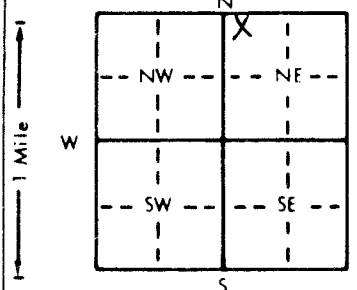


1 LOCATION OF WATER WELL: Fraction NW 1/4 NW 1/4 NE 1/4 Section Number 12 Township Number T 29 S Range Number R 1 E/W
 County: SEDGWICK 27 in town MW4
 Distance and direction from nearest town or city street address of well if located within city?

2 WATER WELL OWNER: Johns DERBY APCO Board of Agriculture, Division of Water Resources
 RR#, St. Address, Box #: 501 N. BALTIMORE Application Number:
 City, State, ZIP Code: DERBY, KS.

3 LOCATE WELL'S LOCATION WITH AN "X" IN SECTION BOX:

 4 DEPTH OF COMPLETED WELL: 66.5 ft. ELEVATION:
 Depth(s) Groundwater Encountered 1. ft. 2. ft. 3. ft.
 WELL'S STATIC WATER LEVEL 46.95 ft. below land surface measured on mo/day/yr
 Pump test data: Well water was ft. after hours pumping gpm
 Est. Yield gpm: Well water was ft. after hours pumping gpm
 Bore Hole Diameter in. to ft. and in. to ft.
 WELL WATER TO BE USED AS:
 1 Domestic 3 Feedlot 6 Oil field water supply 9 Dewatering 12 Other (Specify below)
 2 Irrigation 4 Industrial 7 Lawn and garden only 10 Monitoring well
 Was a chemical/bacteriological sample submitted to Department? Yes No If yes, mo/day/yr sample was submitted
 Water Well Disinfected? Yes No

5 TYPE OF BLANK CASING USED:
 1 Steel 2 PVC 3 RMP (SR) 5 Wrought iron 8 Concrete tile CASING JOINTS: Glued Clamped
 6 Asbestos-Cement 9 Other (specify below) Welded
 4 ABS 7 Fiberglass Threaded
 Blank casing diameter 2 in. to 46.0 ft. Dia. in. to ft. Dia. in. to ft.
 Casing height above land surface 0 in., weight lbs./ft. Wall thickness or gauge No.

TYPE OF SCREEN OR PERFORATION MATERIAL:
 1 Steel 3 Stainless steel 5 Fiberglass 8 RMP (SR) 10 Asbestos-cement
 2 Brass 4 Galvanized steel 6 Concrete tile 9 ABS 11 Other (specify)
 12 None used (open hole)
 SCREEN OR PERFORATION OPENINGS ARE:
 1 Continuous slot 3 Mill slot 5 Gauzed wrapped 8 Saw cut 11 None (open hole)
 2 Louvered shutter 4 Key punched 6 Wire wrapped 9 Drilled holes
 7 Torch cut 10 Other (specify)

SCREEN-PERFORATED INTERVALS: From 46.0 ft. to 66.0 ft. From ft. to ft.
 From ft. to ft. From ft. to ft.
 GRAVEL PACK INTERVALS: From 33.0 ft. to 66.5 ft. From ft. to ft.
 From ft. to ft. From ft. to ft.

6 GROUT MATERIAL: 1 Neat cement 2 Cement grout 3 Bentonite 4 Other
 Grout Intervals: From 0 ft. to 1 ft. From 1 ft. to 28 ft. From 28 ft. to 33 ft.
 What is the nearest source of possible contamination:
 1 Septic tank 4 Lateral lines 7 Pit privy 11 Fuel storage 14 Abandoned water well
 2 Sewer lines 5 Cess pool 8 Sewage lagoon 12 Fertilizer storage 15 Oil well/Gas well
 3 Watertight sewer lines 6 Seepage pit 9 Feedyard 13 Insecticide storage 16 Other (specify below)

Direction from well? How many feet?

FROM	TO	LITHOLOGIC LOG	FROM	TO	PLUGGING INTERVALS
0	4"	CEMENT DRIVEWAY			
4"	6"	SAND			
6"	4'	BROWN ORGANIC TOPSOIL			
4'	13'	BROWN Silty CLAY w/SAND(F)			
13	13.5	SAND (F-M) Moist			
13.5	17.0	Silty BROWN CLAY			
17.0	20.	FINE GRAINED SILTY SAND			
20.	34.	GREY Silty CLAY w/FINE SAND			
34	40	Silty GREY SAND (FINE G.)			
40	44	BROWN SANDY CLAY			
44	49.5	Fine SAND w/silt			
49.5	66.5	SAND (FINE + MED) w/silt			
		WET 50'			

7 CONTRACTOR'S OR LANDOWNER'S CERTIFICATION: This water well was (1) constructed, (2) reconstructed, or (3) plugged under my jurisdiction and was completed on (mo/day/year) 6-22-93 and this record is true to the best of my knowledge and belief. Kansas
 Water Well Contractor's License No. 483 This Water Well Record was completed on (mo/day/yr) 9/6/94
 under the business name of TEST by (signature) Clay P. Dyer