


1 LOCATION OF WATER WELL: County: **Wilson** Fraction: **NW 1/4 SW 1/4 NE 1/4** Section Number: **24** Township Number: **T 29 S** Range Number: **R 4 E**

Distance and direction from nearest town or city street address of well if located within city?

**3.9 miles South of Fredonia**

2 WATER WELL OWNER: **Lafarge**  
 RR#, St. Address, Box # : **1400 S Cement Rd**  
 City, State, ZIP Code : **Fredonia KS 66736**  
 Board of Agriculture, Division of Water Resources  
 Application Number:

3 LOCATE WELL'S LOCATION WITH AN "X" IN SECTION BOX: 4 DEPTH OF COMPLETED WELL: **19' 8"** ft. ELEVATION: **TOC = 867.37**

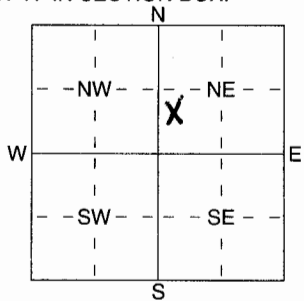

Depth(s) Groundwater Encountered 1 ..... ft. 2 ..... ft. 3 ..... ft.  
 WELL'S STATIC WATER LEVEL **862.53** ft. below land surface measured on mo/day/yr **7-18-00**  
 Pump test data: Well water was ..... ft. after ..... hours pumping ..... gpm  
 Est. Yield ..... gpm: Well water was ..... ft. after ..... hours pumping ..... gpm  
 WELL WATER TO BE USED AS: 5 Public water supply 8 Air conditioning 11 Injection well  
 1 Domestic 3 Feedlot 6 Oil field water supply 9 Dewatering 12 Other (Specify below)  
 2 Irrigation 4 Industrial 7 Domestic (lawn & garden) **0** Monitoring well

Was a chemical/bacteriological sample submitted to Department? Yes ..... No ..... ; If yes, mo/day/yr sample was submitted  
 Water Well Disinfected? Yes No

5 TYPE OF BLANK CASING USED: 1 Steel 3 RMP (SR) 5 Wrought iron 8 Concrete tile CASING JOINTS: Glued ..... Clamped .....  
**2** PVC 4 ABS 6 Asbestos-Cement 9 Other (specify below) Welded .....  
 7 Fiberglass Threaded

Blank casing diameter **2** in. to **19' 8"** ft., Dia ..... in. to ..... ft., Dia ..... in. to ..... ft.  
 Casing height above land surface **30** in., weight ..... lbs./ft. Wall thickness or guage No. ....

TYPE OF SCREEN OR PERFORATION MATERIAL: 1 Steel 3 Stainless Steel 5 Fiberglass **7** PVC 10 Asbestos-Cement  
 2 Brass 4 Galvanized Steel 6 Concrete tile 8 RMP (SR) 11 Other (Specify) .....  
 9 ABS 12 None used (open hole)

SCREEN OR PERFORATION OPENINGS ARE: 1 Continuous slot 3 Mill slot 5 Gauzed wrapped 8 Saw cut 11 None (open hole)  
**1** 2 Louvered shutter 4 Key punched 6 Wire wrapped 9 Drilled holes 10 Other (specify) ..... ft.  
 7 Torch cut

SCREEN-PERFORATED INTERVALS: From **9' 2"** ft. to **19' 2"** ft., From ..... ft. to ..... ft.  
 GRAVEL PACK INTERVALS: From ..... ft. to ..... ft., From ..... ft. to ..... ft.

6 GROUT MATERIAL: 1 Neat cement 2 Cement grout **3** Bentonite 4 Other .....  
 Grout Intervals: From **1** ft. to **7' 3"** ft., From ..... ft. to ..... ft., From ..... ft. to ..... ft.

What is the nearest source of possible contamination:  
 1 Septic tank 4 Lateral lines 7 Pit privy 10 Livestock pens 14 Abandoned water well  
 2 Sewer lines 5 Cess pool 8 Sewage lagoon 11 Fuel storage 15 Oil well/Gas well  
 3 Watertight sewer lines 6 Seepage pit 9 Feedyard 12 Fertilizer storage 16 Other (specify below)  
 13 Insecticide storage

Direction from well? How many feet?

FROM	TO	LITHOLOGIC LOG	FROM	TO	PLUGGING INTERVALS
0	3' 8"	Black silty clay			
3' 8"	4' 8"	grey limestone			
4' 8"	9' 8"	grey shale			
9' 8"	14' 8"	grey limestone			
14' 8"	19' 8"	limestone w/ shale			

7 CONTRACTOR'S OR LANDOWNER'S CERTIFICATION: This water well was **1** constructed, (2) reconstructed, or (3) plugged under my jurisdiction and was completed on (mo/day/year) **2/25/08** and this record is true to the best of my knowledge and belief. Kansas Water Well Contractor's Licence No **570** This Water Well Record was completed on (mo/day/yr) **7/24/00** under the business name of **Aquadrill, Inc.** by (signature) **Myr Kich**