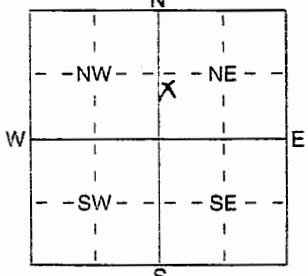


1) LOCATION OF WATER WELL: Fraction NW 1/4 SW 1/4 NE 1/4 Section Number 24 Township Number T 29 S Range Number R 14 EW  
 County: Wilson

Distance and direction from nearest town or city street address of well if located within city?  
 3.9 miles South of Fredonia

2) WATER WELL OWNER: Lafarge  
 RR#, St. Address, Box #: 1700 S. Cement Rd  
 City, State, ZIP Code: Fredonia KS 66736  
 Board of Agriculture, Division of Water Resource  
 Application Number:

3) LOCATE WELL'S LOCATION WITH AN "X" IN SECTION BOX:  
  
 4) DEPTH OF COMPLETED WELL: 27 ft. ELEVATION: 872.13 Tac.  
 Depth(s) Groundwater Encountered 1 7.09 ft. 2 ft. 3 ft.  
 WELL'S STATIC WATER LEVEL: ft. below land surface measured on mo/day/yr  
 Pump test data: Well water was ft. after hours pumping gpr  
 Est. Yield gpm: Well water was ft. after hours pumping gpr  
 WELL WATER TO BE USED AS:  
 5 Public water supply 8 Air conditioning 11 Injection well  
 1 Domestic 3 Feedlot 6 Oil field water supply 9 Dewatering 12 Other (Specify below)  
 2 Irrigation 4 Industrial 7 Domestic (lawn & garden) 10 Monitoring well  
 Was a chemical/bacteriological sample submitted to Department? Yes No; If yes, mo/day/yrs sample was sut  
 mitted Water Well Disinfected? Yes No

5) TYPE OF BLANK CASING USED:  
 1 Steel 3 RMP (SR) 5 Wrought iron 8 Concrete tile CASING JOINTS: Glued Clamped  
 2 PVC 4 ABS 7 Fiberglass 9 Other (specify below) Welded Threaded  
 Blank casing diameter 2.7 in. to 2.7 ft., Dia in. to ft., Dia in. to ft.  
 Casing height above land surface 2.41 ft. in., weight 50 lbs./ft. Wall thickness or gauge No. Sch 40 PVC  
 TYPE OF SCREEN OR PERFORATION MATERIAL:  
 1 Steel 3 Stainless Steel 5 Fiberglass 7 PVC 10 Asbestos-Cement  
 2 Brass 4 Galvanized Steel 6 Concrete tile 8 RMP (SR) 11 Other (Specify)  
 12 None used (open hole)  
 SCREEN OR PERFORATION OPENINGS ARE:  
 1 Continuous slot 3 Mill slot 5 Gauzed wrapped 8 Saw cut 11 None (open hole)  
 2 Louvered shutter 4 Key punched 6 Wire wrapped 9 Drilled holes  
 7 Torch cut 10 Other (specify)  
 SCREEN-PERFORATED INTERVALS: From 17 ft. to 27 ft., From ft. to ft.  
 GRAVEL PACK INTERVALS: From 15.2 ft. to 28.5 ft., From ft. to ft.

6) GROUT MATERIAL: 1 Neat cement 2 Cement grout 3 Bentonite 4 Other  
 Grout Intervals: From 0 ft. to 3 ft., From 3 ft. to 13 ft., From 13 ft. to 15.2 ft.  
 What is the nearest source of possible contamination:  
 1 Septic tank 4 Lateral lines 7 Pit privy 10 Livestock pens 14 Abandoned water well  
 2 Sewer lines 5 Cess pool 8 Sewage lagoon 11 Fuel storage 15 Oil well/Gas well  
 3 Watertight sewer lines 6 Seepage pit 9 Feedyard 12 Fertilizer storage 16 Other (specify below)  
 Direction from well? How many feet?

FROM	TO	LITHOLOGIC LOG	FROM	TO	PLUGGING INTERVALS
0	5	silty clay			
5	9	CKD Brown moist			
9	28.5	Limestone			

7) CONTRACTOR'S OR LANDOWNER'S CERTIFICATION: This water well was (1) constructed, (2) reconstructed, or (3) plugged under my jurisdiction and was completed on (mo/day/year) 8/31/07 and this record is true to the best of my knowledge and belief. Kansas: Water Well Contractor's Licence No 570 This Water Well Record was completed on (mo/day/yr) 11/2/07 under the business name of Aquadrill, Inc. by (signature) Mega Richa