

1 LOCATION OF WATER WELL: Fraction NW 1/4 SW 1/4 NE 1/4 Section Number 24 Township Number T 29 S Range Number R 14 E
 County: Wilson


Distance and direction from nearest town or city street address of well if located within city?

3.9 miles South of Fredonia

2 WATER WELL OWNER: Lafarge
 RR#, St. Address, Box # : 1400 S Clement Rd Board of Agriculture, Division of Water Resource
 City, State, ZIP Code : Fredonia KS 66730 Application Number:

3 LOCATE WELL'S LOCATION WITH 4 DEPTH OF COMPLETED WELL 22.5 ft. ELEVATION: 872.8 top

AN "X" IN SECTION BOX:

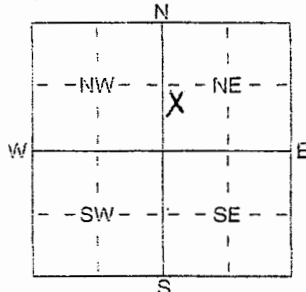

Depth(s) Groundwater Encountered 1 8.34 ft. 2 ft. 3 ft.

WELL'S STATIC WATER LEVEL ft. below land surface measured on mo/day/yr

Pump test data: Well water was ft. after hours pumping gp

Est. Yield gpm: Well water was ft. after hours pumping gp

WELL WATER TO BE USED AS: 5 Public water supply 8 Air conditioning 11 Injection well

1 Domestic 3 Feedlot 6 Oil field water supply 9 Dewatering 12 Other (Specify below)

2 Irrigation 4 Industrial 7 Domestic (lawn & garden) 10 Monitoring well piezometer

Was a chemical/bacteriological sample submitted to Department? Yes No; if yes, mo/day/yr sample was submitted

Water Well Disinfected? Yes No

5 TYPE OF BLANK CASING USED: 5 Wrought iron 8 Concrete tile CASING JOINTS: Glued Clamped

1 Steel 3 RMP (SR) 6 Asbestos-Cement 9 Other (specify below) Welded

2 PVC 4 ABS 7 Fiberglass Threaded

Blank casing diameter in. to 12.5 ft. Dia in. to ft. Dia in. to f

Casing height above land surface 2.46 ft. in. weight Sch 40 lbs./ft. Wall thickness or gauge No.

TYPE OF SCREEN OR PERFORATION MATERIAL: 7 PVC 10 Asbestos-Cement

1 Steel 3 Stainless Steel 5 Fiberglass 8 RMP (SR) 11 Other (Specify)

2 Brass 4 Galvanized Steel 6 Concrete tile 9 ABS 12 None used (open hole)

SCREEN OR PERFORATION OPENINGS ARE: 5 Gauzed wrapped 8 Saw cut 11 None (open hole)

1 Continuous slot 3 Mill slot 6 Wire wrapped 9 Drilled holes

2 Louvered shutter 4 Key punched 7 Torch cut 10 Other (specify)

SCREEN-PERFORATED INTERVALS: From 12.5 ft. to 22.5 ft. From ft. to f

From ft. to ft. From ft. to f

GRAVEL PACK INTERVALS: From 10.1 ft. to 22.5 ft. From ft. to f

From ft. to ft. From ft. to f

6 GROUT MATERIAL: 1 Neat cement 2 Cement grout 3 Bentonite 4 Other

Grout Intervals: From Cement 0 ft. to 3 ft. From 3 ft. to 10.1 ft. From ft. to f

What is the nearest source of possible contamination:

1 Septic tank 4 Lateral lines 7 Pit privy 10 Livestock pens 14 Abandoned water well

2 Sewer lines 5 Cess pool 8 Sewage lagoon 11 Fuel storage 15 Oil well/Gas well

3 Watertight sewer lines 6 Seepage pit 9 Feedyard 12 Fertilizer storage 16 Other (specify below)

Direction from well? How many feet?

FROM TO LITHOLOGIC LOG FROM TO PLUGGING INTERVALS

0 3" Brown silty clay moist

3" 5' Broken limestone

5' 22.5' limestone with small shale streaks

7 CONTRACTOR'S OR LANDOWNER'S CERTIFICATION: This water well was (1) constructed, (2) reconstructed, or (3) plugged under my jurisdiction and was completed on (mo/day/year) 8/30/07 and this record is true to the best of my knowledge and belief. Kansas

Water Well Contractor's Licence No 570 This Water Well Record was completed on (mo/day/yr) 11/5/07

under the business name of Aquadrill Inc. by (signature) Megan Richardson