

1 LOCATION OF WATER WELL: Fraction NW 1/4 SW 1/4 NE 1/4 Section Number 24 Township Number T 29 S Range Number R 14 (EAW)
 County: Wilson


Distance and direction from nearest town or city street address of well if located within city?

3.9 miles South of Fredonia

2 WATER WELL OWNER: Lafarge
 RR#, St. Address, Box #: 1400 S. Cement Rd
 City, State, ZIP Code: Fredonia KS 66730

Board of Agriculture, Division of Water Resource
 Application Number:

3 LOCATE WELL'S LOCATION WITH AN "X" IN SECTION BOX: DEPTH OF COMPLETED WELL 51.75 ft. ELEVATION: 922.98 toe

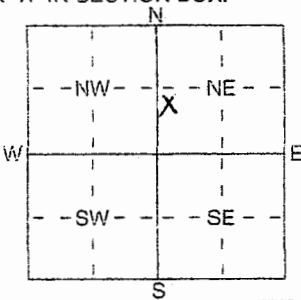

Depth(s) Groundwater Encountered 1 42.38 ft. 2 _____ ft. 3 _____ ft.
 WELL'S STATIC WATER LEVEL _____ ft. below land surface measured on mo/day/yr _____
 Pump test data: Well water was _____ ft. after _____ hours pumping _____ gpm
 Est. Yield _____ gpm: Well water was _____ ft. after _____ hours pumping _____ gpm
 WELL WATER TO BE USED AS:
 1 Domestic 2 Irrigation 3 Feedlot 4 Industrial 5 Public water supply 6 Oil field water supply 7 Domestic (lawn & garden) 8 Air conditioning 9 Dewatering 10 Monitoring well 11 Injection well
(12) Other (Specify below)
Piezometer

Was a chemical/bacteriological sample submitted to Department? Yes _____ No _____; If yes, mo/day/yr sample was submitted
 Water Well Disinfected? Yes _____ No _____

5 TYPE OF BLANK CASING USED:
 1 Steel 2 PVC (2) 3 RMP (SR) 4 ABS
 5 Wrought iron 6 Asbestos-Cement 7 Fiberglass
 8 Concrete tile 9 Other (specify below)
 CASING JOINTS: Glued _____ Clamped _____
 Welded _____
Threaded

Blank casing diameter 2 in. to 41.75 ft. Dia _____ in. to _____ ft. Dia _____ in. to _____ ft.
 Casing height above land surface 2.35 in., weight Sch 40 lbs./ft. Wall thickness or gauge No. _____

TYPE OF SCREEN OR PERFORATION MATERIAL:
 1 Steel 2 Brass 3 Stainless Steel 4 Galvanized Steel 5 Fiberglass 6 Concrete tile 7 PVC (7) 8 RMP (SR) 9 ABS 10 Asbestos-Cement 11 Other (Specify) _____ 12 None used (open hole)

SCREEN OR PERFORATION OPENINGS ARE:
 1 Continuous slot 2 Louvered shutter 3 Mill slot (3) 4 Key punched 5 Gauzed wrapped 6 Wire wrapped 7 Torch cut 8 Saw cut 9 Drilled holes 10 Other (specify) _____ 11 None (open hole)

SCREEN-PERFORATED INTERVALS:
 From 41.75 ft. to 51.75 ft.
 GRAVEL PACK INTERVALS:
 From 39.75 ft. to 51.75 ft.

6 GROUT MATERIAL: 1 Neat cement 2 Cement grout (2) 3 Bentonite 4 Other #deplug
 Grout Intervals: From Cement 0 ft. to 3 ft., From benseel 3 ft. to 30.17 ft., From #deplug 30.17 ft. to 39.75 ft.

What is the nearest source of possible contamination?
 1 Septic tank 2 Sewer lines 3 Watertight sewer lines 4 Lateral lines 5 Cess pool 6 Seepage pit 7 Pit privy 8 Sewage lagoon 9 Feedyard 10 Livestock pens 11 Fuel storage 12 Fertilizer storage 13 Insecticide storage 14 Abandoned water well 15 Oil well/Gas well 16 Other (specify below)

Direction from well? _____ How many feet? _____

FROM	TO	LITHOLOGIC LOG	FROM	TO	PLUGGING INTERVALS
0	2	silty clay			
2	51.75	CKD			

7 CONTRACTOR'S OR LANDOWNER'S CERTIFICATION: This water well was (1) constructed, (2) reconstructed, or (3) plugged under my jurisdiction and was completed on (mo/day/year) 8/10/07 and this record is true to the best of my knowledge and belief. Kansas Water Well Contractor's Licence No 570 This Water Well Record was completed on (mo/day/yr) 11/5/07 under the business name of Aquadrill by (signature) Megan Richards

INSTRUCTIONS: Use typewriter or ball point pen. PLEASE PRESS FIRMLY and PRINT clearly. Please fill in blanks, underline or circle the correct answers. Send top three copies to Kansas Department of Health and Environment, Bureau of Water, Geology Section, 1000 SW Jackson St., Suite 420, Topeka, Kansas 66612-1367. Telephone 785-296-5522. Send one to WATER WELL OWNER and retain one for your records. Fee of \$5.00 for each constructed well.