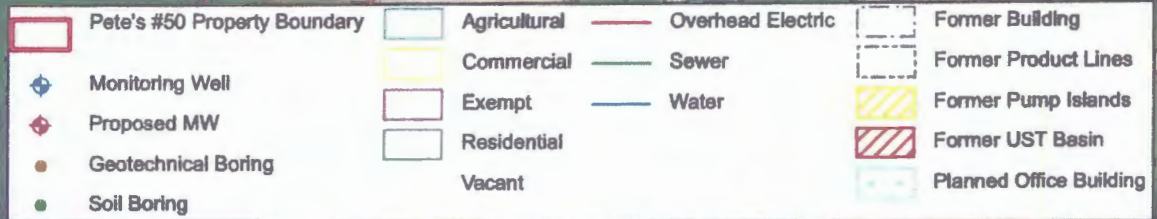


MVV-1

Well ID

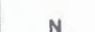

Returned for correction
11/2/20



Notes:

- 1) Groundwater flow direction unknown, but inferred towards the southwest based on topography and regional drainage
- 2) All known utilities visible during the site visit are shown. Figures will be updated following the public and private utility locates conducted during the LSA.



DESIGNED BY: CP		Site Map Pete's #50		Figure 2	Limited Site Assessment Work Plan
DRAWN BY: CP			933 North 2nd Street Fredonia, Kansas U3-103-15140		
CHECKED BY: JM					
APPROVED BY: CC					
DATE: AUGUST 2020					